

CERTIFIED LAND CORNER RESTORATION

Index No. E-21

State of Wisconsin }
County of Lincoln } ss.

History of original corner establishment:

Original Surveyor - Alfred Millard - August, 1861

Witnesses: 7" Maple, N30°W, 3E (sic)
12" White Pine, S70°W, 44 lks
10" Hemlock, S25°E, 55 lks
12" Hemlock, N79°E, 47 lks

I Sheridan D. Schwark, do hereby certify that on the 21st day of June, 19 76, I found evidence of the Southwest section corner of Section 1 Township 35, North, Range 6 East, Fourth, Principal Meridian, as described hereon; and that from this evidence I established a new monument and accessories as described hereon to perpetuate the original location of this corner.

Description of corner evidence found:


Well point found in place and replaced with 2" iron pipe to secure location, as well point was very loose.

Resident witnesses:

.....
.....
.....

Description of monument and accessories I established to perpetuate the original location of this corner.

Set aluminum 30" Lincoln County Bernsten Monument
Witnesses: Spike in 20" Pine, N32°E, 119.7 feet
PK nail in 12" Pine, N10°E, 25.0 feet
PK nail in 12" Pine, N58°W, 30.5 feet
PK nail in Power Pole #3506-1L1, S8°E, 8.0 feet

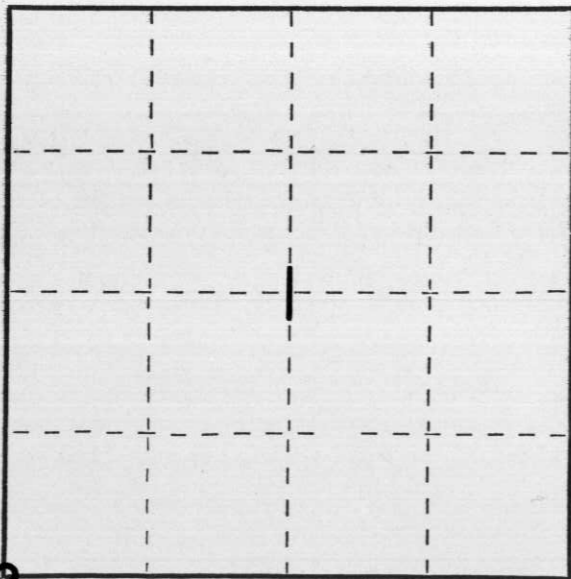

○ = Corner monument restored.

Dated at MERRILL, Wis., this 13TH day of DECEMBER, 1976.

Signature Sheridan D. Schwark Title REGISTERED LAND SURVEYOR Registration No. S-1205
(County Surveyor, Registered Land Surveyor, or other duly authorized official)

Office of Register of Deeds, County of....., I hereby certify that the within instrument was filed in this office for record on the.....day of....., 19..... at.....o'clock..... M..

.....
(Register of Deeds)

By.....Deputy

CERTIFIED LAND CORNER RESTORATION


Index No. E-21

State of Wisconsin }
County of Lincoln } ss.

I, Sheridan D. Schwark, do hereby certify that on the 21st day of June, 19 76, I found evidence of the Southwest section corner of Section 1 Township 35, North, Range 6 East, Fourth, Principal Meridian, as described hereon; and that from this evidence I established a new monument and accessories as described hereon to perpetuate the original location of this corner.

Resident witnesses:

.....
.....
.....

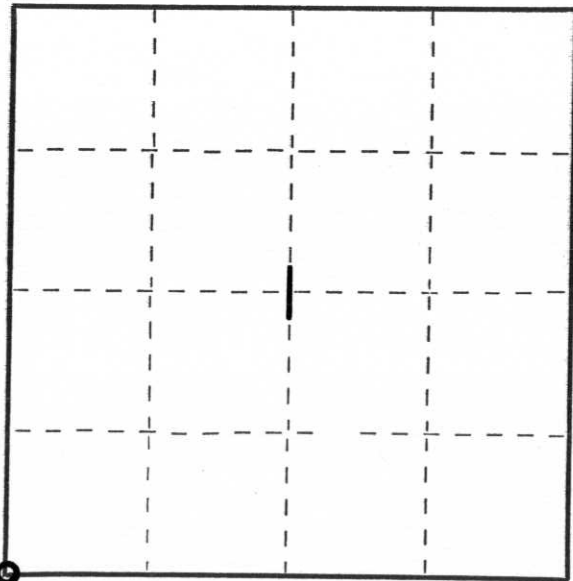

○ = Corner monument restored.

History of original corner establishment:

Original Surveyor - Alfred Millard - August, 1861

Witnesses: 7" Maple, N30°W, 3E (sic)
12" White Pine, S70°W, 44 lks
10" Hemlock, S25°E, 55 lks
12" Hemlock, N79°E, 47 lks

Description of corner evidence found:

Well point found in place and replaced with 2" iron pipe to secure location, as well point was very loose.

Description of monument and accessories I established to perpetuate the original location of this corner.

Set aluminum 30" Lincoln County Bernsten Monument
Witnesses: Spike in 20" Pine, N32°E, 119.7 feet
PK nail in 12" Pine, N10°E, 25.0 feet
PK nail in 12" Pine, N58°W, 30.5 feet
PK nail in Power Pole #3506-1L1, S8°E, 8.0 feet

Dated at MERRILL, Wis., this 13th day of DECEMBER, 1976.

Signature Sheridan D. Schwark Title REGISTERED LAND SURVEYOR Registration No. S-1205
(County Surveyor, Registered Land Surveyor, or other duly authorized official)

Office of Register of Deeds, County of....., I hereby certify that the within instrument was filed in this office for record on the..... day of....., 19..... at..... o'clock..... M.

.....
(Register of Deeds)

By..... Deputy