


CERTIFIED LAND CORNER RESTORATION

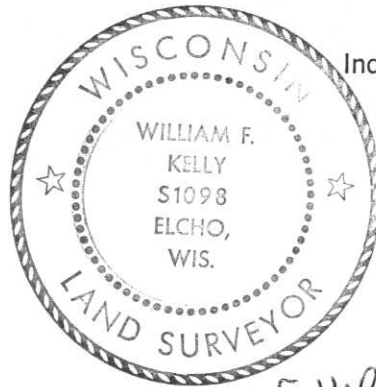

Index No. E-13

State of Wisconsin }
County of LINCOLN } ss.

I, William F. Kelly, do hereby certify that on the 6th day of NOVEMBER, 1974, I found evidence of the North West corner of SECT. 10 Township 35, North, Range 6 E, Fourth, Principal Meridian, as described hereon; and that from this evidence I established a new monument and accessories as described hereon to perpetuate the original location of this corner.

Resident witnesses:


Virginia Davis

History of original corner establishment:

THIS MONUMENT PROBABLY SET ON RESURVEY OF RAILROAD RIGHT OF WAY

Description of corner evidence found:

LOCATED A 4" SQUARE CONCRETE MONUMENT WITH A BRASS CAP MARKED

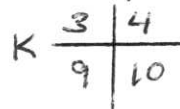



35 6E

FOUND TWO ORIGINAL BEARING TREES TIED TO THE MONUMENT. BOTH TREES SCRIBED.

Description of monument and accessories I established to perpetuate the original location of this corner.

NBT 8" NORWAY PINE

NOTE: NEW BEARING TREES BLAZED AND SCRIBED NBT CHEST HIGH AND MARKED WITH A + AT BASE

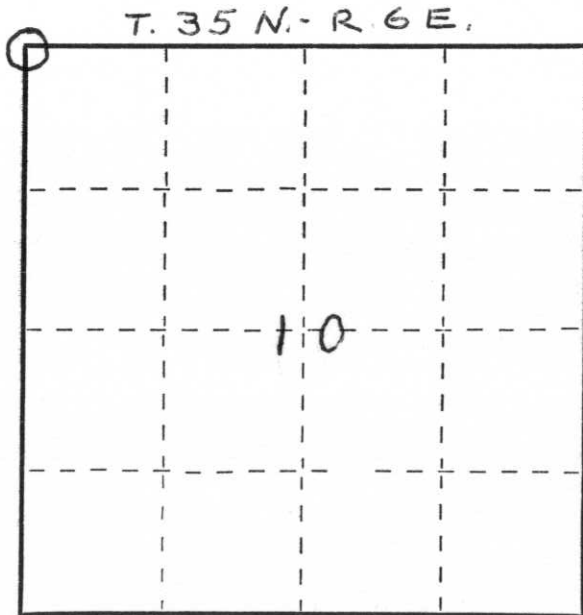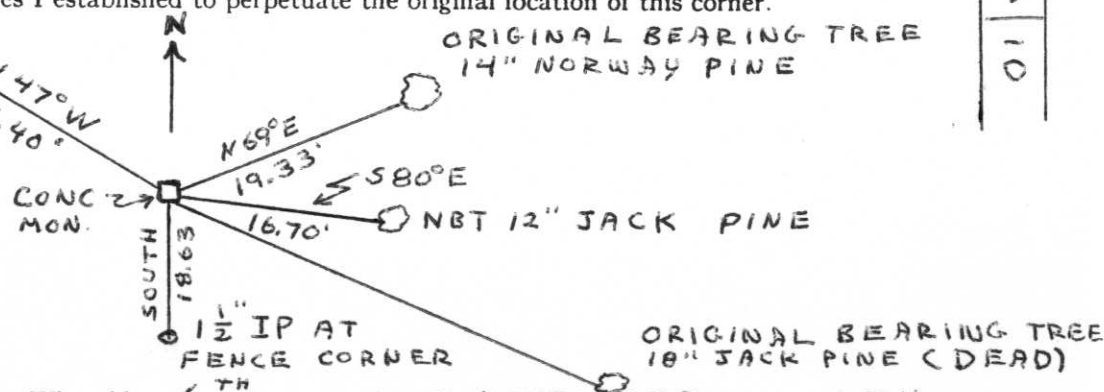

○ = Corner monument restored.

Dated at ELCHO, Wis., this 6th day of NOVEMBER, 1974.

Signature William F. Kelly Title REG. LAND SURVEYOR Registration No. S-1098
(County Surveyor, Registered Land Surveyor, or other duly authorized official)

Office of Register of Deeds, County of _____, I hereby certify that the within instrument was filed in this office for record on the _____ day of _____, 19____ at _____ o'clock _____ M.

(Register of Deeds)

By _____ Deputy

SECT 10 35 6E