


CERTIFIED LAND CORNER RESTORATION

Index No. E-9

State of Wisconsin }
County of Lincoln } ss.

I Lester J. Schmit, do hereby certify that on the 7th day of July, 1976, I found evidence of the Northeast corner of Section 8 Township 35, North, Range 6 East, Fourth, Principal Meridian, as described hereon; and that from this evidence I established a new monument and accessories as described hereon to perpetuate the original location of this corner.

Resident witnesses:

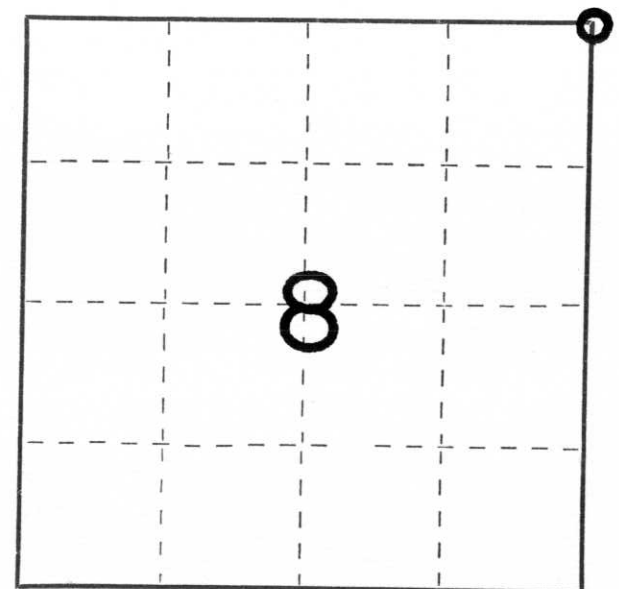

○ = Corner monument restored.

History of original corner establishment:
Surveyor: Alfred Millard
Date: 22 October 1861
Monumentation: Wood Post
Witnesses: Tamarac 10 S 60° W 68 links
Tamarac 6 N 15° E 35 links

Description of corner evidence found: The base of a wood post and a 1½" iron pipe badly rusted on top. No other evidence.

Description of monument and accessories I established to perpetuate the original location of this corner.
Berntsen Monument - 30" (Set monument 1" above surface)

- P.K. Nail in 15" Tamarack; N 10° E; 75.46'
- 1" Iron Pipe; N 89° E; 13.47'
- 1" Iron Pipe; S 3° E; 27.59'
- P.K. Nail in 11" White Pine; S 87° W; 71.44'

Dated at Tomahawk, Wis., this 27th day of July, 1976.

Signature Lester J. Schmit Title Land Surveyor Registration No. S-1192
(County Surveyor, Registered Land Surveyor, or other duly authorized official)

Office of Register of Deeds, County of _____, I hereby certify that the within instrument was filed in this office for record on the _____ day of _____, 19____ at _____ o'clock _____ M.

(Register of Deeds)

By _____ Deputy