

CERTIFIED LAND CORNER RESTORATION

Index No. E-5

State of Wisconsin }
 County of Lincoln } ss.

History of original corner establishment:
 The original Government Survey was performed by Alfred Millard, Deputy Surveyor
 October, 1860 to July 1861

I John H. Fisher, do hereby
 certify that on the 20 day
 of October, 1983, I found
 evidence of the Southwest
 corner of Section 5
 Township 35, North, Range
6 East, Fourth, Principal Meridian,
 as described hereon; and that from this evidence
 I established a new monument and accessories
 as described hereon to perpetuate the original
 location of this corner.

Wood post set			
Tamarack	12"	N10°E	160 links
Cedar	10"	S32°W	35 links

Description of corner evidence found:

1" iron pipe			
Jack Pine	9"	N41°W	61.7 feet
Jack Pine	8"	N58°E	76.0 feet


Resident witnesses:

None

Description of monument and accessories I established to perpetuate the original location of this corner.

Replaced 1" iron pipe with Lincoln County Berntsen Monument stamped to identify corner

Set nail in Jack Pine	9"	N41°W	62.09 feet
Set nail in Jack Pine	8"	N58°E	76.36 feet
Set nail in Jack Pine	5"	N 3°E	76.51 feet
Set nail in Maple	5"	S48°W	79.40 feet

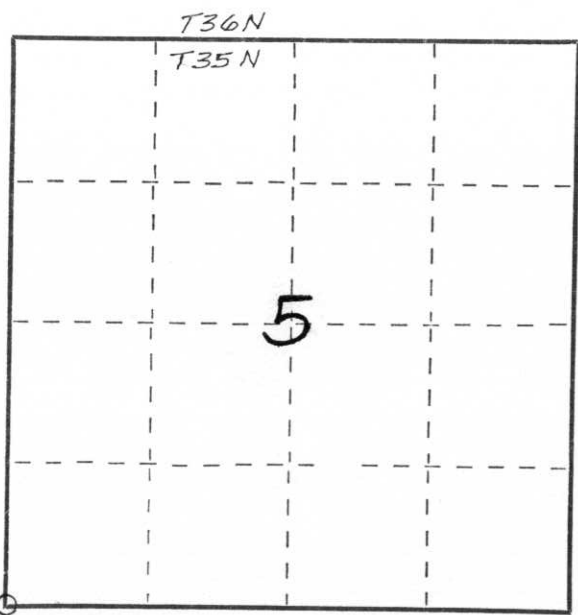

○ = Corner monument restored.



Dated at Minocqua, Wis., this 27th day of October, 1983

Signature John H. Fisher Title Registered Land Surveyor Registration No. S-836
 (County Surveyor, Registered Land Surveyor, or other duly authorized official)

Office of Register of Deeds, County of _____, I hereby certify that the within
 instrument was filed in this office for record on the _____ day of _____, 19____
 at _____ o'clock _____ M.

 (Register of Deeds)

By _____ Deputy