

CERTIFIED LAND CORNER RESTORATION


Index No. C-5

State of Wisconsin }
County of Lincoln } ss.

I Lester J. Schmit, do hereby
certify that on the 17th day
of September, 1977, I found
evidence of the East 1/4
corner of Section 6
Township 35, North, Range
6 East, Fourth, Principal Meridian,
as described hereon; and that from this evidence
I established a new monument and accessories
as described hereon to perpetuate the original
location of this corner.

Resident witnesses:

.....
.....
.....

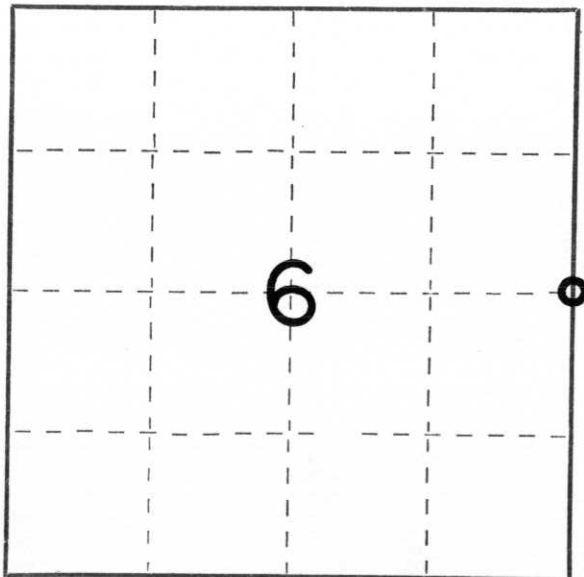

○ = Corner monument restored.

History of original corner establishment:

Surveyor: Alfred Millard
Date: 28 October 1860
Monumentation: Wood Post
Witnesses: Yellow Pine 12"; N 45° E; 26 links
Yellow Pine 10"; S 32° W; 16 links

Description of corner evidence found: 2" iron pipe, the top being 6" above ground.

Description of monument and accessories I established to perpetuate the original location of this corner.

Berntsen Monument - 30" (set flush with ground)

P.K. Nail in 8" Jack Pine; N 39°59'21" E; 9.07'
Northwest corner of large building foundation; S 69°52'53" E; 39.70'
P.K. Nail in 8" Jack Pine; S 04°07'27" W; 35.07'
P.K. Nail in 7" Jack Pine; N 77°36'15" W; 47.84'

Dated at Tomahawk, Wis., this 2nd day of March, 1978.

Signature Lester J. Schmit Title Land Surveyor Registration No. S-1192
(County Surveyor, Registered Land Surveyor, or other duly authorized official)

Office of Register of Deeds, County of _____, I hereby certify that the within
instrument was filed in this office for record on the _____ day of _____, 19____
at _____ o'clock _____ M.

.....
(Register of Deeds)

By _____ Deputy