

U.S. PUBLIC LAND SURVEY MONUMENT RECORD

Note: This form is intended and designed to fulfill all requirements of the Wisconsin Administrative Code, Chapter A-E 7.08 U.S. Public Land Monument Record (3)(a)(b)(c)(d)(e)(f)(g)(h)(i). An additional sheet may be added if necessary to conform with said requirements.


(a) CORNER LOCATION:

East Quarter Corner of Section 9
 Township 35 North
 Range 6 East
 Town of Bradley
 County of Lincoln

North:
 East:
 Datum:
 GNSS Method:
 GNSS Control:

(RECORDING AREA)

SECTION 9

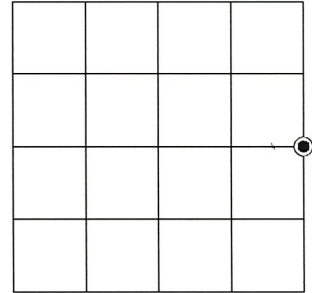

(b) HISTORY OF ORIGINAL CORNER ESTABLISHMENT

Original Surveyor:
 Date of Survey: Commenced
 Completed
 Original B.T.'S


SEE PREVIOUS U.S.P.L.S. MONUMENT RECORD DATED JUNE 28, 1974.

(f)(g)(h) DESCRIPTION OF MONUMENT FOUND AT THIS CORNER AND IF IT WAS ACCEPTED, STATE ALL EVIDENCE (MATERIAL, TESTIMONIAL, OCCUPATIONAL, PLATS, RECORD, OTHER MONUMENTS) USED AS A BASIS FOR ESTABLISHING LOCATION. IF NOT ACCEPTED OR IF NOTHING WAS FOUND, STATE EVIDENCE USED AS BASIS FOR ESTABLISHING LOCATION. IF REESTABLISHED THROUGH LOST CORNER PROPORTIONATE METHODS, INDICATE ALL MONUMENTS, DISTANCES AND DIRECTIONS USED TO ESTABLISH. INDICATE TYPE OF MONUMENT AND SIGN POST FOUND OR SET.


This is a perpetuation of a previous U.S.P.L.S. Monument Record by William Kelly, RLS, dated June 28, 1974, and filed in the office of the Lincoln County Register of Deeds. A complete history of the corner can be found on the previous monument record. I accept the previous location as a true and faithful perpetuation or reestablishment of the original corner location and further perpetuate it as follows.

June 11, 2019, I, James D. Rein, P.L.S. No. S-1234, found a P.K. mag nail in the pavement of Half Moon Road and Essex Road. We recovered Kelly's easterly red (Norway) pine and his P.K. nail in the power pole to the southwest. See below for updated witnesses.

(c)(d)(e) PLAN VIEW OF CORNER WITH TIES TO AT LEAST 4 WITNESS MONUMENTS. IF IN DISAGREEMENT WITH PREVIOUSLY ESTABLISHED CORNER, SHOW THE DISTANCE BETWEEN THE TWO CORNERS AND ALSO INDICATE THE TIES TO THE DISPUTED CORNER.

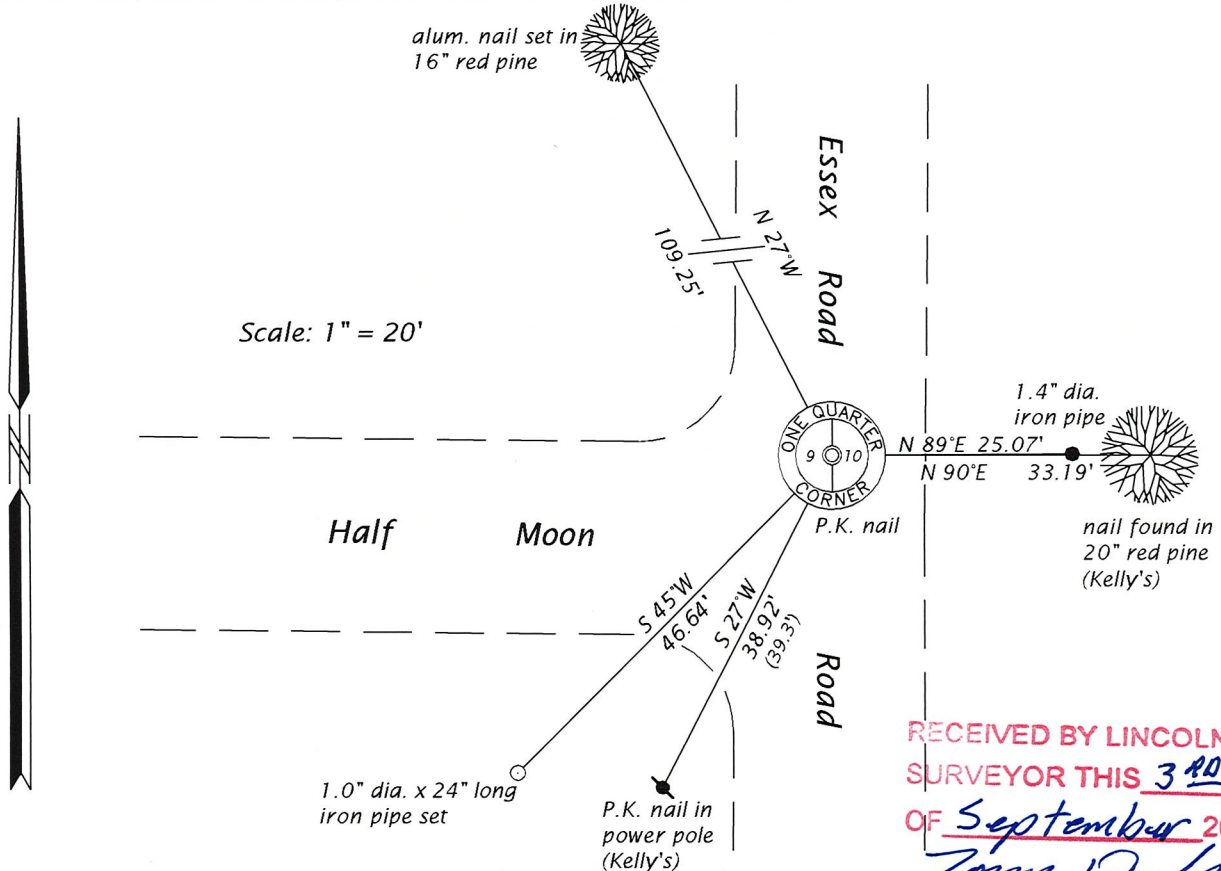

RECEIVED BY LINCOLN COUNTY SURVEYOR THIS 3RD DAY OF September 20 19
Tommy Dahn
 COUNTY SURVEYOR

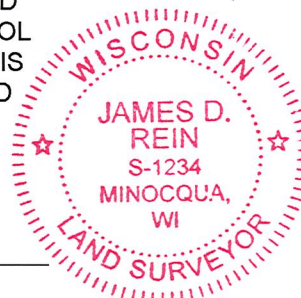

(i) I, JAMES D. REIN, PROFESSIONAL LAND SURVEYOR NO. S-1234 HEREBY CERTIFY THAT THE CORNER LOCATION ON THIS RECORD WAS DETERMINED BY ME OR UNDER MY DIRECTION AND CONTROL AND THAT THIS U.S. PUBLIC LAND SURVEY MONUMENT RECORD IS CORRECT AND COMPLETE TO THE BEST OF MY KNOWLEDGE AND BELIEF.

James D. Rein
 SIGNATURE DATE Aug. 28, 2019


INDEX NO. G - 13

CERTIFIED LAND CORNER RESTORATION

Index No. G-13

State of Wisconsin }
County of LINCOLN } ss.

History of original corner establishment:

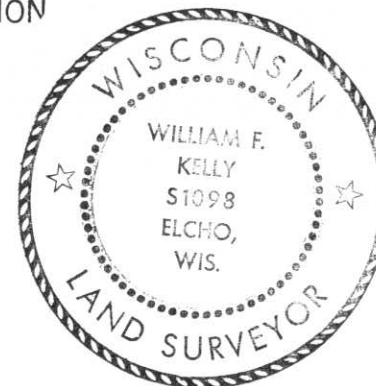

William F. Kelly
28 June 1974

I William F. Kelly, do hereby certify that on the 14th day of JUNE, 1974, I found evidence of the WEST 1/4 corner of SECT 10 Township 35, North, Range 6, Fourth, Principal Meridian, as described hereon; and that from this evidence I established a new monument and accessories as described hereon to perpetuate the original location of this corner.

Description of corner evidence found:

Located well point Pipe driven thru road pavement from scribed Blaze Tree East of corner and a second Blaze Tree N.E. of corner location.



Resident witnesses:

Tom Davis

New Monument Marked \rightarrow $\frac{1}{4}$ SECT. COR.
9 | 10
T35N R6E
WFK

Description of monument and accessories I established to perpetuate the original location of this corner.

*Set Lincoln Co. Monument slush with Asphalt Road Surface
14" Dead Jack Pine with Original Blaze*

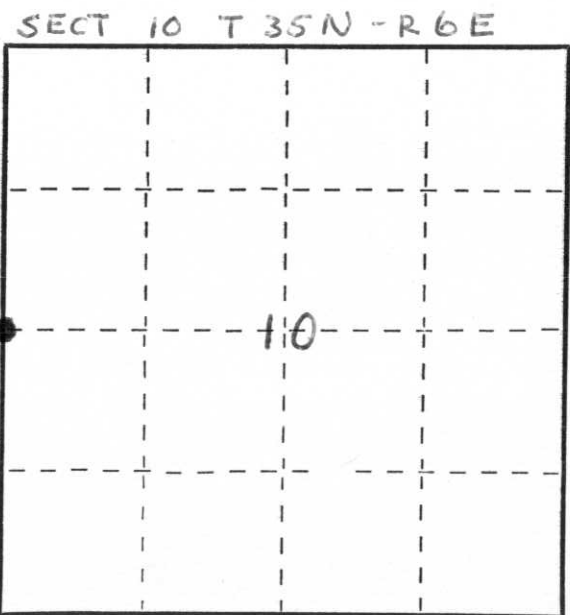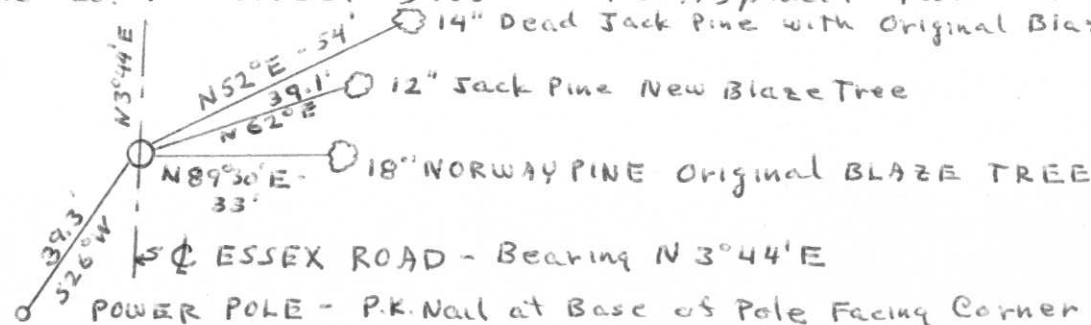

● = Corner monument restored.

Dated at _____, Wis., this 28th day of JUNE, 1974.

Signature William F. Kelly Title Registered Land Surveyor Registration No. 51098
(County Surveyor, Registered Land Surveyor, or other duly authorized official)

Office of Register of Deeds, County of _____, I hereby certify that the within instrument was filed in this office for record on the _____ day of _____, 19____ at _____ o'clock _____ M.

(Register of Deeds)

By _____ Deputy