


CERTIFIED LAND CORNER RESTORATION

Index No. K-17

State of Wisconsin }  
County of Lincoln } ss.

I Lester J. Schmit, do hereby  
certify that on the 11th day  
of July, 1977, I found  
evidence of the East 1/4  
corner of Section 15  
Township 35, North, Range  
6 East, Fourth, Principal Meridian,  
as described hereon; and that from this evidence  
I established a new monument and accessories  
as described hereon to perpetuate the original  
location of this corner.

Resident witnesses:

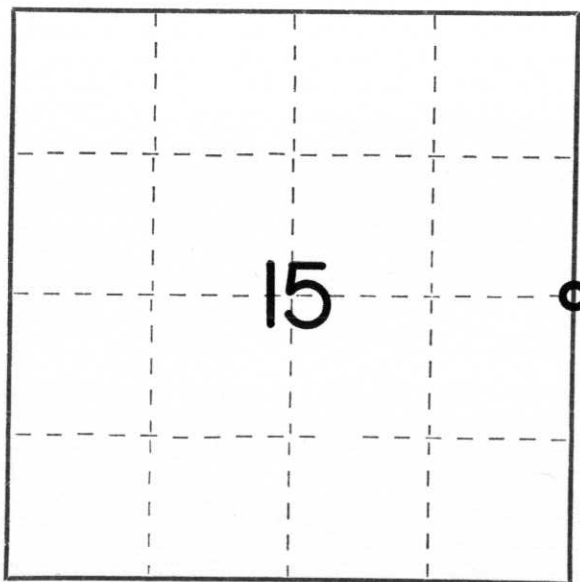

○ = Corner monument restored.

History of original corner establishment:

Surveyor: Alfred Millard  
Date: 20 October 1860  
Monumentation: Wood Post  
Witnesses: Spruce 5; S 37° W; 70 links  
Spruce 6; N 13° E; 74 links

Description of corner evidence found: 1" iron pipe and scribed wood post.

P.K. Nail in 8" Black Spruce; N 66°23'45" E; 8.68'  
P.K. Nail in 10" Tamarac; S 02°44'39" E; 9.89'

Description of monument and accessories I established to perpetuate the original location of this corner.

Berntsen Monument - 30" (set 2" above ground)

P.K. Nail in 6" Black Spruce; S 72°48'52" W; 15.05'  
P.K. Nail in 6" Black Spruce; N 48°17'14" W; 7.36'

Dated at Tomahawk, Wis., this 2nd day of March, 1978.

Signature Lester J. Schmit Title Land Surveyor Registration No. S-1192  
(County Surveyor, Registered Land Surveyor, or other duly authorized official)

Office of Register of Deeds, County of \_\_\_\_\_, I hereby certify that the within  
instrument was filed in this office for record on the \_\_\_\_\_ day of \_\_\_\_\_, 19\_\_\_\_  
at \_\_\_\_\_ o'clock \_\_\_\_\_ M.

\_\_\_\_\_  
(Register of Deeds)

By \_\_\_\_\_ Deputy