

CERTIFIED LAND CORNER RESTORATION

Index No. K-9

State of Wisconsin }  
County of Lincoln } ss.

History of original corner establishment:

I Anthony B. Kiedrowski, do hereby certify that on the 28th day of September, 19 76, I found evidence of the west quarter corner of Sec. 16-35-6E Township....., North, Range....., Fourth, Principal Meridian, as described hereon; and that from this evidence I established a new monument and accessories as described hereon to perpetuate the original location of this corner.

Original corner set by Deputy Surveyor Alfred Millard, Oct, 1961

Description of corner evidence found:


This corner re-established by retracing a survey done by RLS Louis Lembcke, 4/16/66. Excavated by hand and found a spike in underlying roadbed. Ex Accepted this point as correct after running an EDM and T-2 traverse of the entire section. Set a standard aluminum Berstein monument.

Resident witnesses:

.....  
.....  
.....

Description of monument and accessories I established to perpetuate the original location of this corner.

See tie sketch on reverse side.

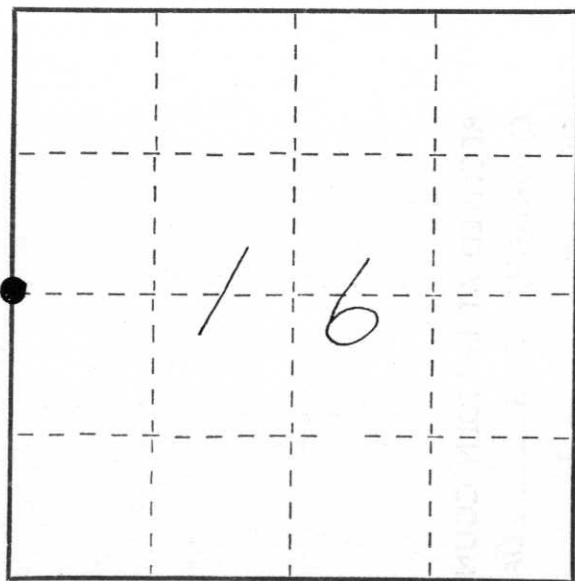

○ = Corner monument restored.



Dated at Wis. Rapids, Wis., this 5th day of Oct., 19 76

Signature ABKiedrowski Title Reg. Land Surveyor Registration No. S-878  
(County Surveyor, Registered Land Surveyor, or other duly authorized official)

Office of Register of Deeds, County of....., I hereby certify that the within instrument was filed in this office for record on the..... day of....., 19..... at..... o'clock..... M.

.....  
(Register of Deeds)

By..... Deputy

W 1/4 CORNER 16-35-6



POWER POLE / NAIL & RLS-878 DISC

TANNERY ROAD

N 15° E  
127.14'

30.42' TACKED STAKE

78.25'  
S 17° E

POWER POLE / NAIL & RLS-878 DISC

TRIPLE 12" WHITE PINE / BT  
NAIL & RLS-878 DISC



TWIN 8" NORWAY PINE / BT  
NAIL & RLS-878 DISC



RECEIVED AT LINCOLN COUNTY  
COURTHOUSE THIS 21<sup>ST</sup> DAY  
OF Nov 1976.  
Pat Wheeler  
TAX DESCRIPTION OFFICE