

CERTIFIED LAND CORNER RESTORATION


Index No. 9-5

State of Wisconsin }
County of Lincoln } ss.

I Lester J. Schmit, do hereby certify that on the 5th day of December, 1983, I found evidence of the Northeast corner of Section 30 Township 35, North, Range 6 East, Fourth, Principal Meridian, as described hereon; and that from this evidence I established a new monument and accessories as described hereon to perpetuate the original location of this corner.

Resident witnesses:

.....
.....
.....

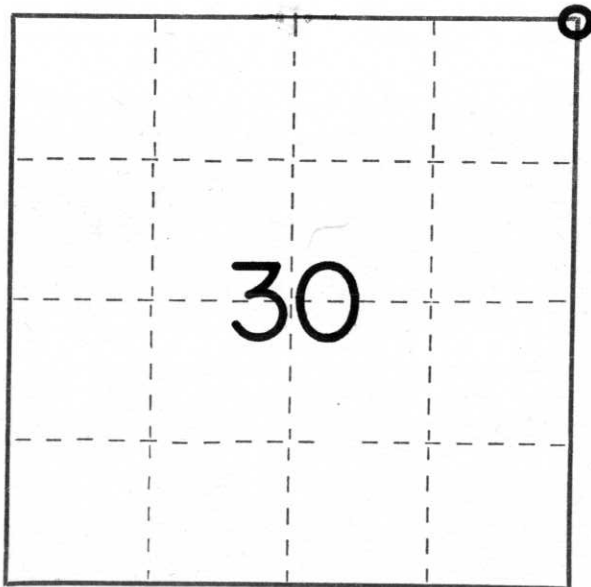

○ = Corner monument restored.

History of original corner establishment:

Surveyor: Alfred Millard
Date: 21 October 1861
Monumentation: Wood Post
Witnesses: tamarac 9, N 20° E, 33 links
tamarac 9, S 15° W, 10 links

Description of corner evidence found: Found a 1½" 2 3.5' iron pipe for the corner. A 5" x 5" squared wood post is just to the north of the corner. A fence line from the west ends at the corner. Witnesses: 7" cedar, S 62° E, 11.24'
11" cedar, S 79° W, 13.94'

Description of monument and accessories I established to perpetuate the original location of this corner.
Replaced iron pipe with Berntsen monument for corner, mounded with sand.
Witnesses: 8" soft maple, S 46° W, 17.64'
6" balsm, N 42° W, 28.53'

Dated at Tomahawk, Wis., this 10th day of September, 1984.

Signature Lester J. Schmit Title Land Surveyor Registration No. S-1192
(County Surveyor, Registered Land Surveyor, or other duly authorized official)

Office of Register of Deeds, County of _____, I hereby certify that the within instrument was filed in this office for record on the _____ day of _____, 19____ at _____ o'clock _____ M.

.....
(Register of Deeds)
By _____ Deputy