

U.S. PUBLIC LAND SURVEY MONUMENT RECORD


Note: This form is intended and designed to fulfill all requirements of Wisconsin Administrative Code, Chapter A-E 5.02, U.S. Public Land Survey Monument Record (3) (a) (b) (c) (d) (e) (f) (g) (h) (i). An additional sheet may be added if necessary to conform with said requirements.

(a) Corner location: Township 35 North

Range 6 East

Town Bradley

County Lincoln

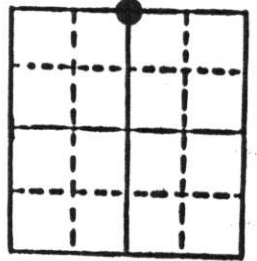

Section 30

b) (f) (g) (h) Description of monument found at this corner and if it was accepted, state all evidence (material, testimonial, occupational, plats, records, other monuments) used as a basis for accepting. If not accepted or if nothing was found, state evidence used as basis for establishing location. If reestablished through lost corner proportionate methods, indicate all monuments, distances and directions used to establish. During this past spring's thaw, the top of the Berntsen monument which marks this corner was frost heaved above the surface of the blacktop. Using the method suggested by the Berntsen Monument Company for placement of their markers in these frost heave prone areas, I reset the corner in its original location. All references are the same as noted on the previously filed form.

c) (d) (e) Plan view of corner with ties to at least 4 witness monuments. If in disagreement with previously established corner, show the distances between the two corners and also indicate the ties to the disputed corner.

(i) I, Lester J. Schmit
(type or print name) certify that the corner location on this record was determined by me or under my direction and control and that this U.S. Public Land Survey Monument Record is correct and complete to the best of my knowledge and belief.

Lester J. Schmit 12 May 86
Signature Date



Index No 2-3


CERTIFIED LAND CORNER RESTORATION

Index No. Q-3

State of Wisconsin }
County of Lincoln } ss.

I Lester J. Schmit, do hereby certify that on the 18th day of November, 1983, I found evidence of the North 1/4 corner of Section 30 Township 35, North, Range 6 East, Fourth, Principal Meridian, as described hereon; and that from this evidence I established a new monument and accessories as described hereon to perpetuate the original location of this corner.

Resident witnesses:

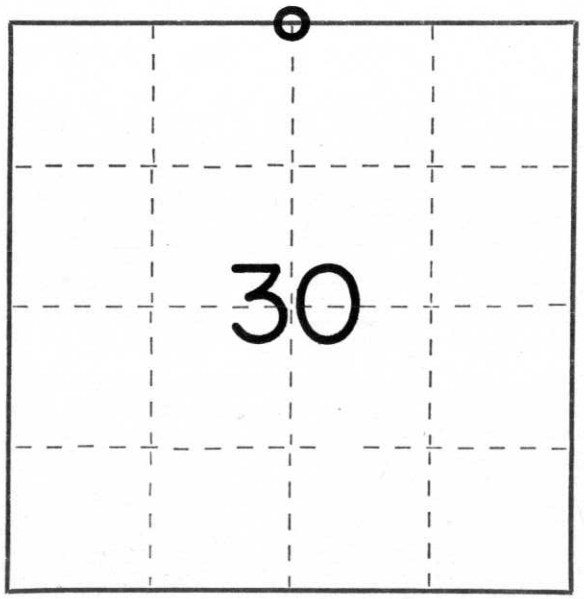

○ = Corner monument restored.

History of original corner establishment:

Surveyor: Alfred Millard
Date: 21 October 1861
Monumentation: Wood Post
Witnesses: maple 12, S 67° W, 32 links
white birch 18, North, 32 links

Description of corner evidence found: Found a 2" x 2" iron bar in the centreline of County Trunk Highway "CC" and a southerly extension of the centreline of Wildwood Road.

Description of monument and accessories I established to perpetuate the original location of this corner.

Set a Berntsen monument 3" below the surface of County Trunk Highway "CC" for the corner.

Witnesses: 20" norway pine, N 17° E, 74.13'
17" white spruce, S 7° E, 27.06'
8" soft maple, S 29° W, 49.48'
9" norway pine, N 15° W, 61.36'

Dated at Tomahawk, Wis., this 7th day of September, 1984.

Signature: Lester J. Schmit Title Land Surveyor Registration No. S-1192
(County Surveyor, Registered Land Surveyor, or other duly authorized official)

Office of Register of Deeds, County of _____, I hereby certify that the within instrument was filed in this office for record on the _____ day of _____, 19____ at _____ o'clock _____ M.

(Register of Deeds)

By _____ Deputy