## U.S. PUBLIC LAND SURVEY MONUMENT RECORD


This form is intended and designed to fulfill all requirements of Wisconsin Administrative Code, Chapter A-E 5.02, U.S. Note: Public Land Survey Monument Record (3) (a) (b) (c) (d) (e) (f) (g) (h) (i). An additional sheet may be added if necessary to

(a) Corner location: Township\_ \_North

Range 6 East

Bradley

Lincoln County .

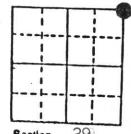

b) (f) (g) (h) Description of monument found at this corner and if it was accepted, state all evidence (material, testimonial, occupational, plats, records, other monuments) used as a basis for accepting. If not accepted or if nothing was found, state evidence used as basis for establishing location. If reestablished through lost corner proportionate methods, indicate all monuments, distances and directions used to establish. Original Gov't. Survey: July 1861 by Alfred Millard, set wood post for corner with bearings, spruce pine 10 S 46 W 18 links & spruce pine 14 N 64 E 37 links. During survey work in 1978 in Section 21, found the iron pipe which marked the Southwest corner of Section 21. A witness post was westerly of the corner. I have replaced this iron pipe with a Berntsen monument for the corner and witnessed as shown below.

c) (d) (e) Plan view of corner with ties to at least 4 witness monuments. If in disagreement with previously established corner, show the distances between the two corners and also indicate the ties to the

Berntsen monument set to replace 11/4" Not to scale. All witnesses are iron pipes. LESTER J.

Lester J. Schmit

(type or print name) certify that the corner location on this record was determined by me or under my direction and control and that this U.S. Public Land Survey Monument Record is correct and complete to the best of my knowledge and belief.

Signature Date

