

# U.S. PUBLIC LAND SURVEY MONUMENT RECORD


Note: This form is intended and designed to fulfill all requirements of Wisconsin Administrative Code, Chapter A-E 7.08 U.S. Public Land Survey Monument Record (3) (a) (b) (c) (d) (e) (f) (g) (h) (i). An additional sheet may be added if necessary to conform with said requirements.

(a) Corner location: Township 35 North

Range 6 East/West

Town/City/Village BRADLEY

County LINCOLN

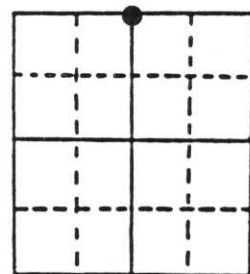


Section 29

(b) (f) (g) (h) Description of monument found at this corner and if it was accepted, state all evidence (material, testimonial, occupational, plats, records, other monuments) used as a basis for accepting. If not accepted or if nothing was found, state evidence used as basis for establishing location. If reestablished through lost corner proportionate methods, indicate all monuments, distances and directions used to establish. Indicate type of monument found or set and sign post.

July 1861 Alfred Millard set wood post for corner  
 September 13 1977 O.I. set iron pipe BT's Tam 5" S59°E 34',  
 Birch N21°W 26'.  
 August 2000 I found 1 1/4" I.P. in swamp just south of high  
 ground. Replaced it with Lincoln County Monument & witnessed  
 it as shown below.

(c) (d) (e) Plan view of corner with ties to at least 4 witness monuments. If in disagreement with previously established corner, show the distances between the two corners and also indicate the ties to the disputed corner.

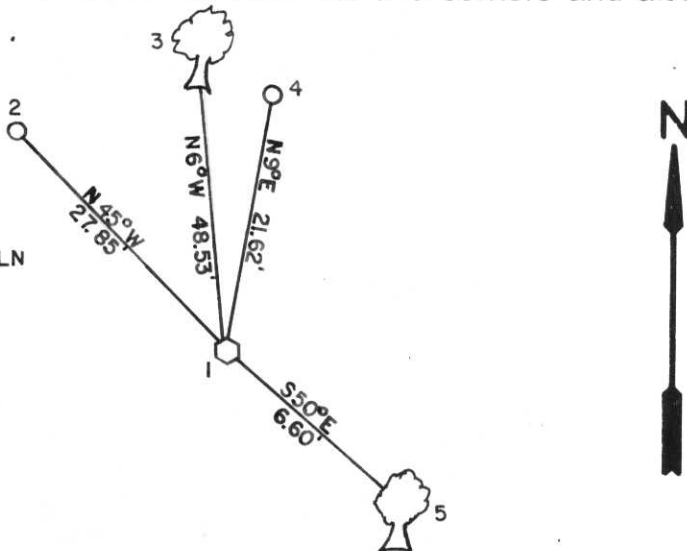

- 1) REPLACED 1 1/4" IRON PIPE WITH LINCOLN COUNTY MONUMENT.
- 2) SET 5/8" RE-BAR WITH CAP
- 3) SET SPIKE IN SIDE OF 18" R.PINE
- 4) SET 5/8" RE-BAR WITH CAP
- 5) SET SPIKE IN SIDE OF 5" TAMARACK WITH SIGN

- NO SCALE  
 - BEARINGS TAKEN WITH HANDHELD COMPASS

RECEIVED AT LINCOLN COUNTY  
 COURTHOUSE THIS 13<sup>TH</sup> DAY  
 OF August 20 01  
*Tom Walker*  
 LAND INFORMATION OFFICE

(i) I, RUSSELL F. BROWN  
 (type or print name) certify that the corner location on this record was determined by me or under my direction and control and that this U.S. Public Land Survey Monument Record is correct and complete to the best of my knowledge and belief.

Russell F. Brown 8/10/01  
 Signature Date



Stamp

Index No. 8-1