

U S PUBLIC LAND SURVEY MONUMENT RECORD

NOTE: This form is intended and designed to fulfill all requirements of Wisconsin Administrative Code, Chapter A-E 7.08 U.S. Public Land Survey Monument Record (3) (a-i)

A-E 7.08(3)(a) Identity of corner:
 SOUTH 1/4 CORNER SECTION 22,
 TOWNSHIP 35 NORTH,
 RANGE 06 EAST OF THE 4TH PM,
 CITY OF TOMAHAWK,
 COUNTY OF LINCOLN

WISCORS - LINCOLN COUNTY
 N: 237,672.742 USft (237,672.888)
 E: 383,419.554 USft (383,419.488)
 Datum: NAD83 (2011)
 GNSS Method RTN - Direct
 GNSS Control WISCORS VRS



The coordinate value shown has been verified by the average of two or more GPS observations at a markedly different time. Coordinates shown in parenthesis are provided by Lincoln County.

A-E 7.08(3)(b)


Original Surveyor: Alfred Millard

Date of Original Survey	Commenced:	October 18, 1860	Original Accessories:		
	Completed:	July 21, 1861	Spruce	4	N 42° E 10 Links
			Spruce	6	S 70° W 46 Links

July ??, 19?? - Surveyor 1192 - Lester J. Schmidt - indicate this position as "???" on Lincoln County map M71B.
 September 27, 1988 Surveyor 1192 - Lester J. Schmidt - indicate this position as "Berntsen Monument found in place" on Lincoln County map M228B.
 August 20, 1996 - Surveyor 1192 - Lester J. Schmidt - indicate this position as "Berntsen Monument found in place" on Lincoln County map L350A.
 January 8, 1992 - Surveyor 1192 - Lester J. Schmidt - indicate this position as "Berntsen Monument to be set during the spring of 1992" on Lincoln County map L176B.
 July 10, 2001 - Surveyor 1845 - David L. Lemke - indicates this position as "Found PK nail" on Lincoln County map M445A.
 May 15, 2002 - Surveyor 1192 - Lester J. Schmidt - indicate this position as "P.K. nail found in place" on Lincoln County map M459B.
 June 13, 2002 - Surveyor 1845 - David L. Lemke - indicates this position as "Found PK nail" on Lincoln County map M467B.
 September 19, 2002 - Surveyor 1192 - Lester J. Schmidt - indicate this position as "nail in blacktop found in place" on Lincoln County map
 December 18, 2007 - Surveyor 1451 - Eugene C. Uttech - indicates this position as "PK nail, found" on Lincoln County map L512B.
 November 16, 2010 - Surveyor 1451 - Eugene C. Uttech - indicates this position as "Berntsen SMN-1 set" on Lincoln County map S431A.
 February 24, 2015 - Surveyor 2729 - Gregory S. Maines - indicates this position as "Steel survey nail found" on Lincoln County map L507A.

September 27, 2022 - While performing the 2022 Lincoln County PLSS Corner Remonumentation and GPS Services project, I found a Berntsen Survey Mark steel spike near the computed position provided by Lincoln County. The monument is ±3 feet east of Willow Lane centerline (south), and on the centerline of Willow Lane (north) and County Trunk Highway A. I established 4 new reference monuments as shown below.

A-E 7.08(3)(c)(d) Plan view of corner with references to at least 4 witness monuments.

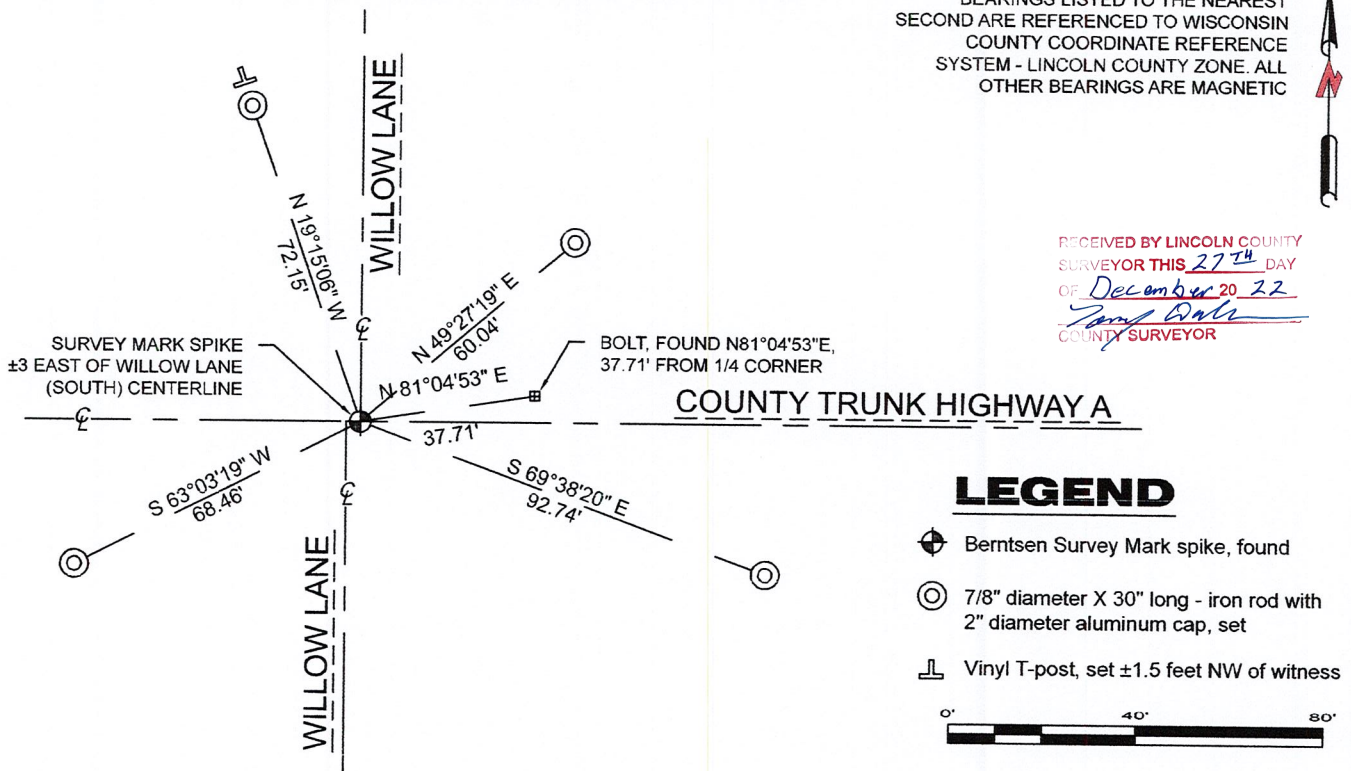


A-E 7.08(3)(e) 1860 Surveyor set a post, 1988 - 2015 the position was occupied by a monument. I found a Berntsen Survey Mark steel spike.

A-E 7.08(3)(f) I accept this monument as a FOUND PERPETUATED LOCATION of the corner.

A-E 7.08(3)(g)(h) This corner was not determined through lost-corner-proportionate methods.

A-E 7.08(3)(i) I, Jeffrey L. DeMuth, Professional Land Surveyor No. S-2656, hereby certify that the corner location on this record was determined by the Lincoln County Surveyor, and the monuments found or set as shown hereon were measured by me or under my direction and control, and that this U.S. Public Land Survey Monument Record is correct and complete to the best of my knowledge, and belief.

SIGNATURE _____ DATE December 14, 2022

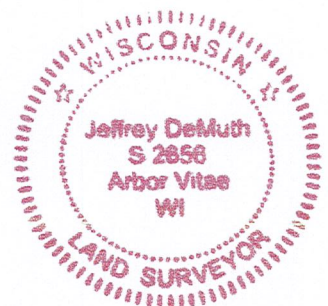

8-15

REPORT

2022-Lincoln County PLSS Corner Remonumentation and GPS Services

Wisconsin Corner Point Identification Number: 43506220020
Surveyor: Jeffrey L. DeMuth – S2656
Corner monument: Found Berntsen “Survey Mark” steel spike.

Field Book: Cardinal North – Lincoln Co. Remon. – 2022-00
Page: 48

Horizontal Datum: WisCRS – Lincoln County Zone – NAD83(2011)

Date / time of initial measurement:
September 27, 2022 - Start 12:20:51 CDT – End 12:29:22 CDT


Reference monuments:
4 – Set - 7/8” diameter X 30” long iron rods with 2” diameter Lincoln Co. aluminum cap.

Coordinate Table


	County Provided	2022 Measurement	Difference
North	237672.888	237672.742	0.15
East	383419.488	383419.554	-0.07

Observed coordinates match with existing coordinates within reason.
Request Data Log for more information.

Additional Notes:
Corner falls ± 3 feet east of Willow Lane centerline (south), on Willow Lane centerline (north),
and on C.T.H. A centerline.

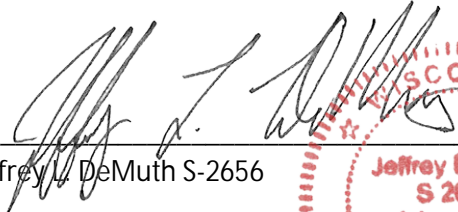
Jeffrey L. DeMuth S-2656

October 7, 2022
Date

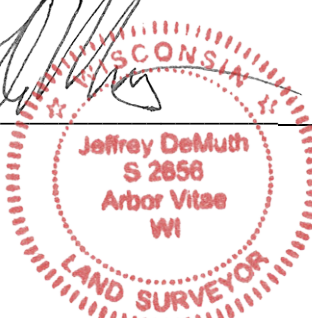

43506220020_Mon-N



43506220020_North



43506220020_West



43506220020_South



43506220020_East

