

U.S. PUBLIC LAND SURVEY MONUMENT RECORD


Note: This form is intended and designed to fulfill all requirements of Wisconsin Administrative Code, Chapter A-E 5.02, U.S. Public Land Survey Monument Record (3) (a) (b) (c) (d) (e) (f) (g) (h) (i). An additional sheet may be added if necessary to conform with said requirements.

(a) Corner location: Township 35 North


Range 6 East

Town Bradley


County Lincoln

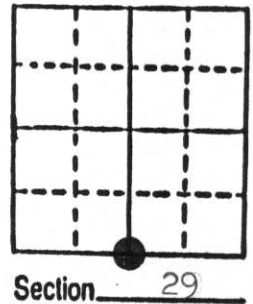

b) (f) (g) (h) Description of monument found at this corner and if it was accepted, state all evidence (material, testimonial, occupational, plats, records, other monuments) used as a basis for accepting. If not accepted or if nothing was found, state evidence used as basis for establishing location. If reestablished through lost corner proportionate methods, indicate all monuments, distances and directions used to establish. Original Government Survey: July 1861 by Alfred Millar set wood post for corner with bearings, yellow pine 10 N 34 W 30 links & spruce pine 5 S 3 E 36 links. Upon a search for the corner location, I found nothing. A survey by Louis W. Lembcke set the 1/16 corner on the section line west of this corner. I doubled the distance from the Southwest corner of Section 29 (a Berntsen monument) through Lembcke's 1/16 corner to establish this corner location, as shown below.

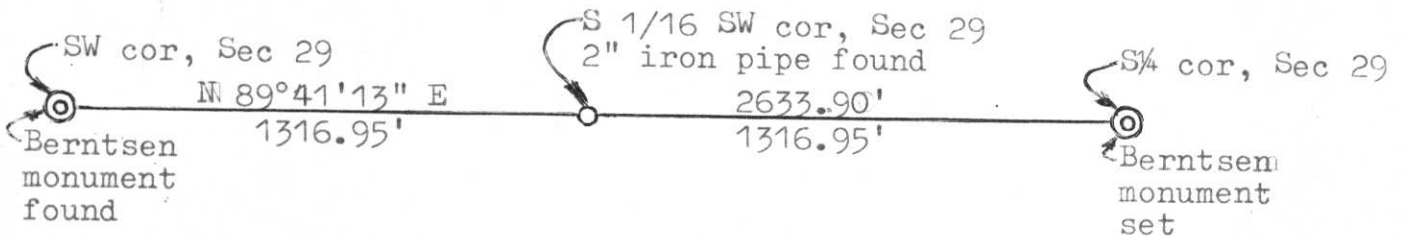

c) (d) (e) Plan view of corner with ties to at least 4 witness monuments. If in disagreement with previously established corner, show the distances between the two corners and also indicate the ties to the disputed corner.

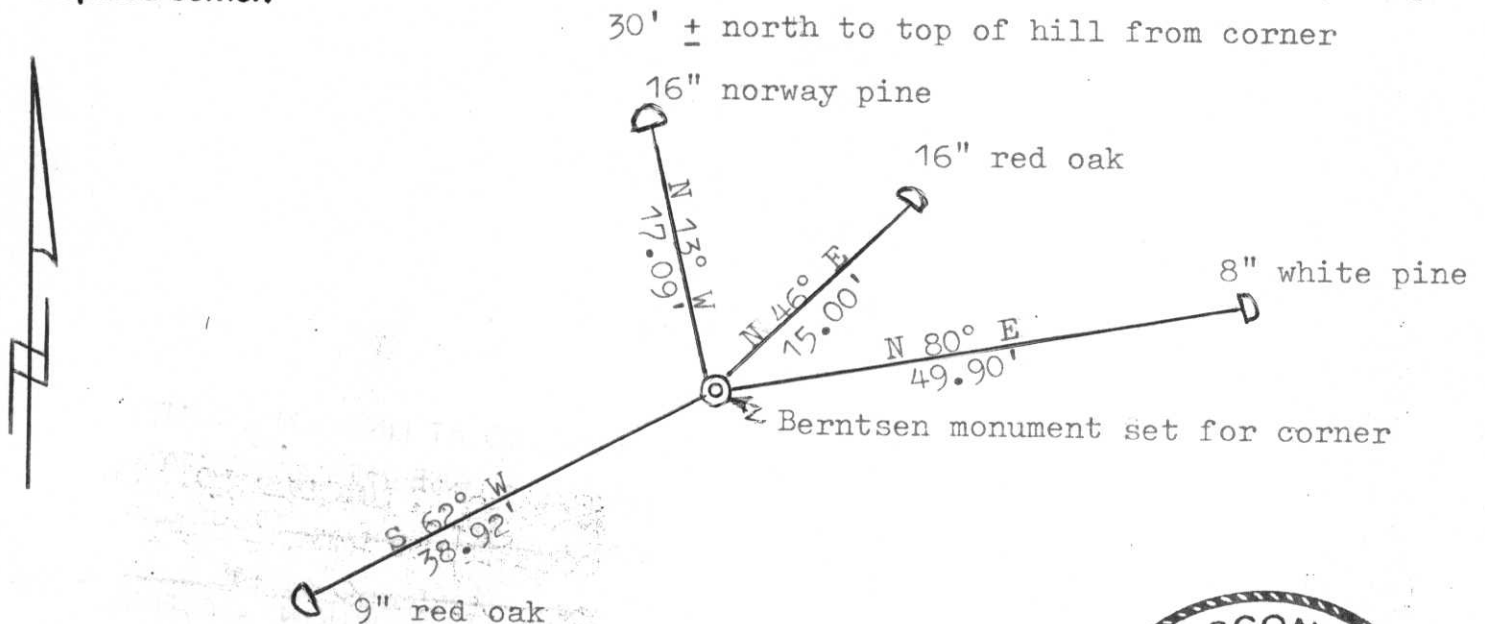

(i) I, Lester J. Schmit
 (type or print name) certify that the corner location on this record was determined by me or under my direction and control and that this U.S. Public Land Survey Monument Record is correct and complete to the best of my knowledge and belief.

Lester J. Schmit 10 Dec 90
 Signature Date



Index No. 4-2