


CERTIFIED LAND CORNER RESTORATION

Index No. 4-5

State of Wisconsin }
County of Lincoln } ss.

I, Stuart L. Foltz, do hereby certify that on the 18th day of April, 19 75, I found evidence of the northwest corner of Section 32 Township 35, North, Range 6 East, Fourth, Principal Meridian, as described hereon; and that from this evidence I established a new monument and accessories as described hereon to perpetuate the original location of this corner.

Resident witnesses:
.....
.....
.....

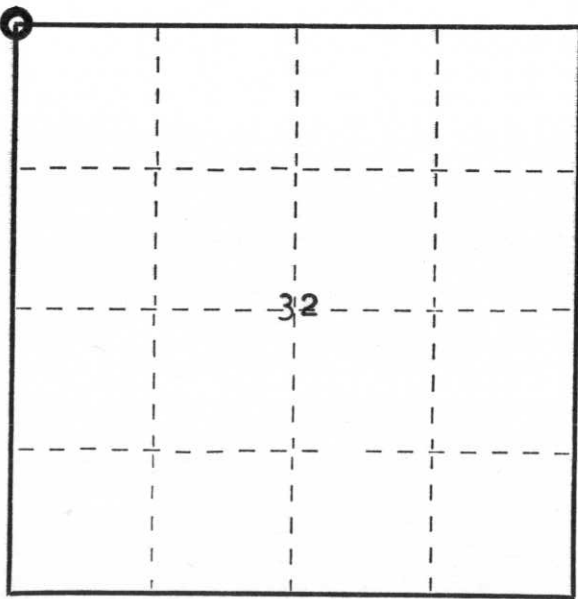

○ = Corner monument restored.

History of original corner establishment:

Surveyor: Alfred Millard
Date: October, 1861
Monument: Wood post
Witnesses: Yellow pine 18 N28W 55 lks
Yellow pine 12 S84E 28 lks

Description of corner evidence found:

1 1/4" diameter iron pipe found 1" under blacktop of Peaceful Valley Road, witnessed by 12" Norway Pine S76°W, 14.8' and 13" Norway Pine N53°W, 26.0' set by R. H. Winat in December, 1972 from bearing trees found. Shown on June, 1958 survey by Anton W. Kordick.

Description of monument and accessories I established to perpetuate the original location of this corner.

Replaced iron pipe found with Lincoln County cast aluminum Bernsten monument.
Put P.K. nail with disc in the two bearing trees found (12" Norway Pine S76°W, 14.8' and 13" Norway Pine, N53°W, 26.0')
Set P.K. nail with disc in new BT's:
10" Norway Pine S18°E, 81.6'
8" White Pine S 1°W, 59.5'

Dated at Minocqua, Wis., this 1st day of July, 19 75

Signature Stuart L. Foltz Title Reg. Land Surveyor Registration No. S-1170
(County Surveyor, Registered Land Surveyor, or other duly authorized official)

Office of Register of Deeds, County of _____, I hereby certify that the within instrument was filed in this office for record on the _____ day of _____, 19 _____ at _____ o'clock _____ M.

.....
(Register of Deeds)

By _____ Deputy