## U.S. PUBLIC LAND SURVEY MONUMENT RECORD


This form is intended and designed to fulfill all requirements of Wisconsin Administrative Code, Chapter A-E 5.02, U.S. Public Land Survey Monument Record (3) (a) (b) (c) (d) (e) (f) (g) (h) (i). An additional sheet may be added if necessary to conform with said requirements.

(a) Corner location: Township\_ \_\_North

Range 6 East

City of Tomahawk

Lincoln County \_

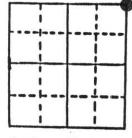

Section\_

b) (f) (g) (h) Description of monument found at this corner and if it was accepted, state all evidence (material, testimonial, occupational, plats, records, other monuments) used as a basis for accepting. If not accepted or if nothing was found, state evidence used as basis for establishing location. If reestablished through lost corner proportionate methods, indicate all monuments, distances and directions used to establish.

directions used to establish. Original Gov't. Survey: Aug. 1851 by James Marsh, set wood post for corner with bearings, spruce 8 S 10° E 23 links, spruce 8 S 11° I 1 links, yellow pine 16 N 12° W 88 links & yellow pine 16 N 39° E 155 links. I found a 1½" iron pipe at the Southwest corner of Atcherson & Larson Subdivi-

sion for the corner.

c) (d) (e) Plan view of corner with ties to at least 4 witness monuments. If in disagreement with previously established corner, show the distances between the two corners and also indicate the ties to the disputed corner. B"N. PINE

Replaced 11/2" iron pipe with Berntsen monument.

Lester J. Schmit

(type or print name) certify that the corner location on this record was determined by me or under my direction and control and that this U.S. Public Land Survey Monument Record is correct and complete to the best of my knowledge and belief.

Signature

