

FIELD SURVEY NOTES


PRESERVATION OF LANDMARKS

(Pursuant to Section 59.635(7) Wisconsin Statutes

E-D-707-69

State of Wisconsin / Department of Transportation


COUNTY		
LINCOLN		
TOWN		
BRADLEY		
HIGHWAY		
USH 51		
SECTION	TOWNSHIP	RANGE
36	T35N	R6E
TYPE OF LANDMARK		
BERNTSEN MAG. ALUM MONUMENTS		

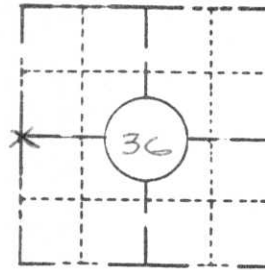

LOCATION SKETCH
(Location of landmark indicated by "x")



This space for copy of field notes or ties to the above described landmarks

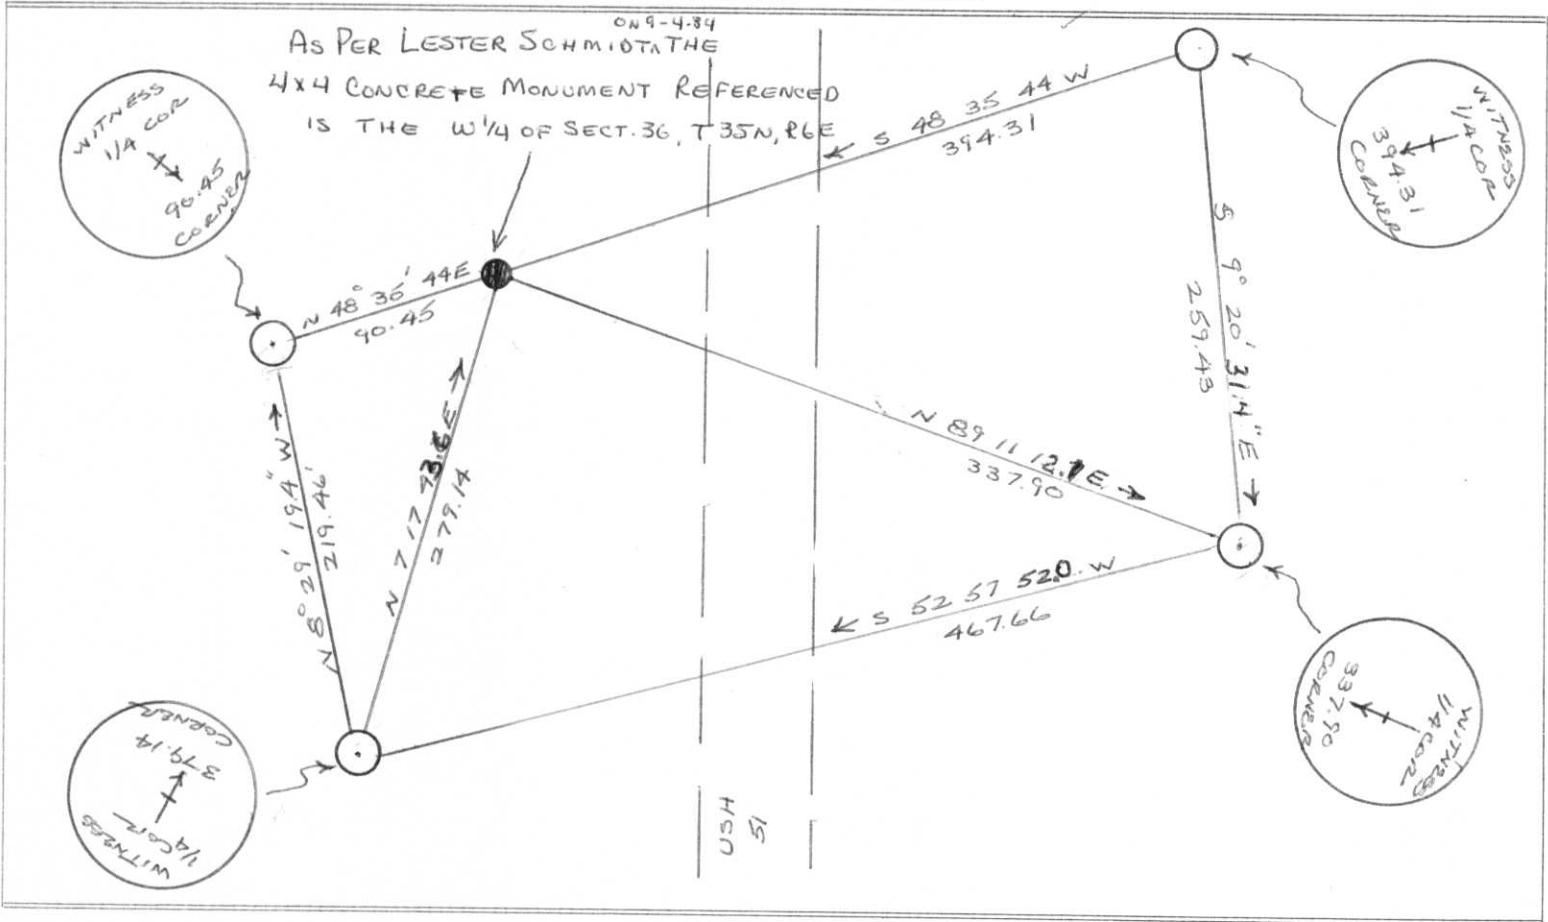

FILED UNDER PROJECT		
1173-03-71		
DISTRICT OFFICE NUMBER	CITY	COUNTY
7	RHINELANDER	ONEIDA
LOCATED OR ESTABLISHED BY		
NAME ROBERT B. JOHNSON		
TITLE SURVEY CREW CHIEF DATE 8-16-84		

COUNTY CLERK'S OFFICE	
COUNTY OF LINCOLN	WISCONSIN } SS
DATE RECEIVED FOR RECORD	DATE COPY SENT TO COUNTY SURVEYOR
SIGNATURE OF COUNTY CLERK	
<i>Ken Alderson</i>	

W-21

T35N

R6E W-21


Nov. 5, 1971



Note: Corner found by using survey plat furnished by NORTHWOODS SURVYORS.

N 598, 515.16
E 2,078, 863.62
W. 1/4 Cor. Sec. 36-35-6E
4" x 4" Concrete Monument
and old I.P. Found by
Manninghoff & Scherer 11/5/71

No fence North,
East or West.

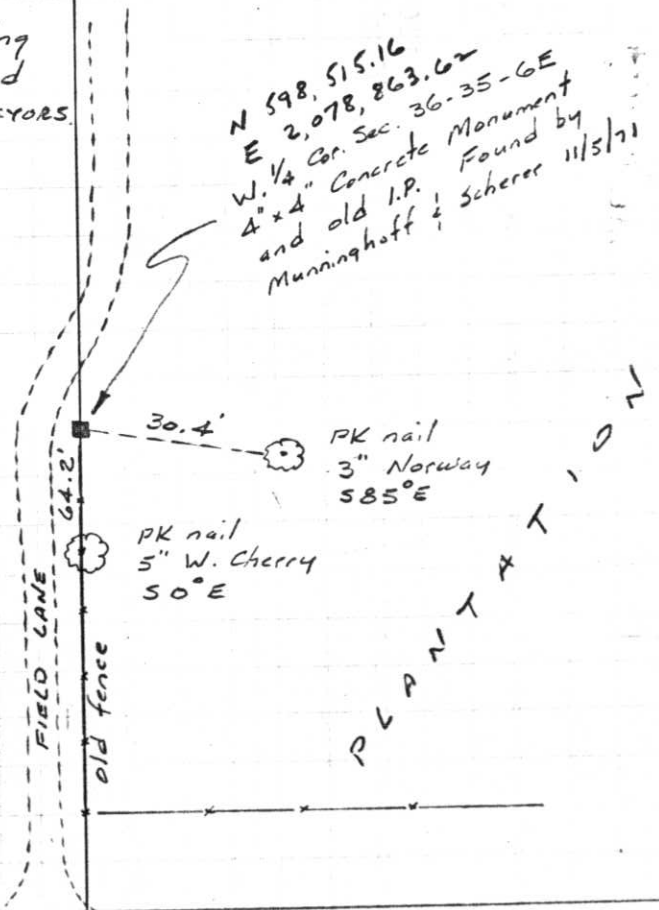

Project I.D. 1173-3-00 C.T.H. "S"-
U.S.H.8 U.S.H. 51 Freeway Lincoln
Co. Wm. Scherer Surveyor Received
from Division of Hwy's Jan. 11, 1973

CTH " D (B.t.)