

U.S. PUBLIC LAND SURVEY MONUMENT RECORD


Note: This form is intended and designed to fulfill all requirements of Wisconsin Administrative Code, Chapter A-E 5.02, U.S. Public Land Survey Monument Record (3) (a) (b) (c) (d) (e) (f) (g) (h) (i). An additional sheet may be added if necessary to conform with said requirements.

(a) Corner location: Township 35 North

Range 7 & 8 East

Town Harrison

County Lincoln

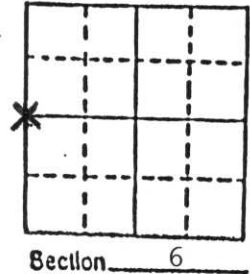

b) (f) (g) (h) Description of monument found at this corner and if it was accepted, state all evidence (material, testimonial, occupational, plats, records, other monuments) used as a basis for accepting. If not accepted or if nothing was found, state evidence used as basis for establishing location. If reestablished through lost corner proportionate methods, indicate all monuments, distances and directions used to establish.

August 1860, Alfred Millard set post for 1/4 corner:

14" White Pine, N13°E, 17 links (11.22')

16" White Pine, N44°W, 4 links (2.64')

1949, Genisot Engineering of Rhinelander, WI used this position to subdivide section 1, to the West.

4/6/88 Milo E. Stefan found position marked by a 3/4" iron pipe and scribed 4" x 4" x 5' cedar post and 3 references with PK nail in face of stump blaze:

8" White Pine, S77°E, 19.90'

4" White Birch, N67°W, 24.96'

5" Aspen, S14°W, 7.41'

I accept this as the restored position and replaced post and iron pipe with a Lincoln County Monument.


c) (d) (e) Plan view of corner with ties to at least 4 witness monuments. If in disagreement with previously established corner, show the distances between the two corners and also indicate the ties to the disputed corner.

1. Cast aluminum monument with embossed screw on cap, Lincoln County, in mound of earth and stone.
2. 10" White Birch, N29°E, 47.48' (1/2 S BT)
- *3. 8" White Pine, S77°E, 19.90'
- *4. 5" Aspen, S14°W, 7.41'
- *5. 4" White Birch, N67°W, 24.96'
6. Reset 4" x 4" x 5' scribed cedar post, N45°E, 1.5'

*PK nail in stump blaze.

Distances measured from nail in side of BTs.

(Scribed accordingly)

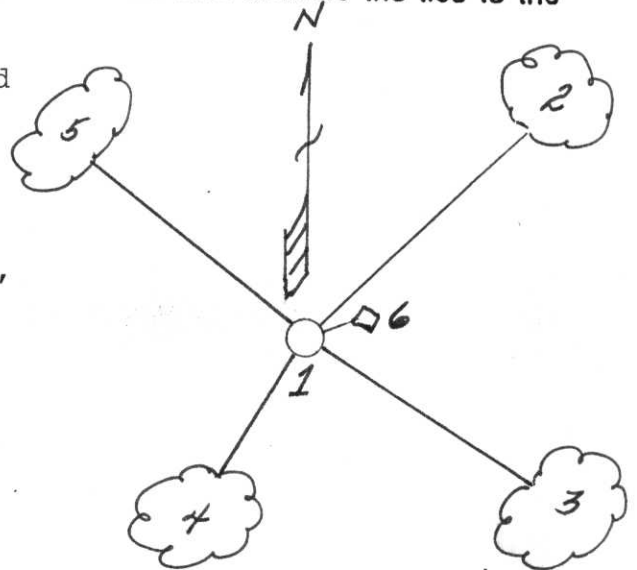

(i) I, Milo E. Stefan

(type or print name) certify that the corner location on this record was determined by me or under my direction and control and that this U.S. Public Land Survey Monument Record is correct and complete to the best of my knowledge and belief.

Milo E. Stefan

4/27/88

Signature

Date



Index No. C-1