


U.S. PUBLIC LAND SURVEY MONUMENT RECORD

NOTE: This form is intended and designed to fulfill all requirements of Wisconsin Administrative Code, Chapter A-E 7.08 U.S. Public Land Survey Monument Record (S)(a)(b)(c)(d)(e)(f)(g)(h)(i). An additional sheet may be added if necessary to conform with said requirements.

(a) Corner location: Township 35 North
 Range 07 East
 Town of KING
 LINCOLN County, Wisconsin

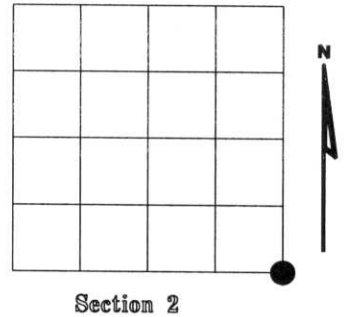

(b)(f)(g)(h) Description of monument found at this corner and if it was accepted, state all evidence (material, testimonial, occupational, plats, records, other monuments) used as a basis for accepting. If not accepted or if nothing was found, state evidence used as basis for establishing location. If reestablished through lost corner proportionate methods, indicate all monuments, distances and directions used to establish. Indicate type of monument found or set and sign post.


- 1861 - Original corner set by Alfred Millard
- 1949 - F.R. Wincentzen and J.M. Abernathy set 5"x5" post
 Old BTs: J. Pine 10" S40°E 20.4'
 J. Pine 11" N28°W 15'
 J. Pine 12" S81°E 39'
- 1950 - WPS Corp fund stake at corner location replaced with 3" dia. 6' long iron pipe, 3' above ground
- 1961 & 1980 - Bill Stuth, Owens - Illinois found pipe, accepts as corner.
- 2003 - I found 3" dia. iron pipe up 3' above ground. Accept as corner.

Witnessed corner as shown below.

(c)(d)(e) Plan view of corner with ties to at least 4 witness monuments. If in disagreement with previously established corner, show the distances between the two corners and also indicate the ties to the disputed corner.

RECEIVED AT LINCOLN COUNTY
 COURTHOUSE THIS 11TH DAY
 OF June 20 03
Tony Dahn
 LAND INFORMATION OFFICE

- 3" DIA. IRON PIPE
- ◇ SET 3/4" DIA. ROD WITH ALUMINUM CAP
- T PLASTIC "T" SIGN POST NORTH 1'

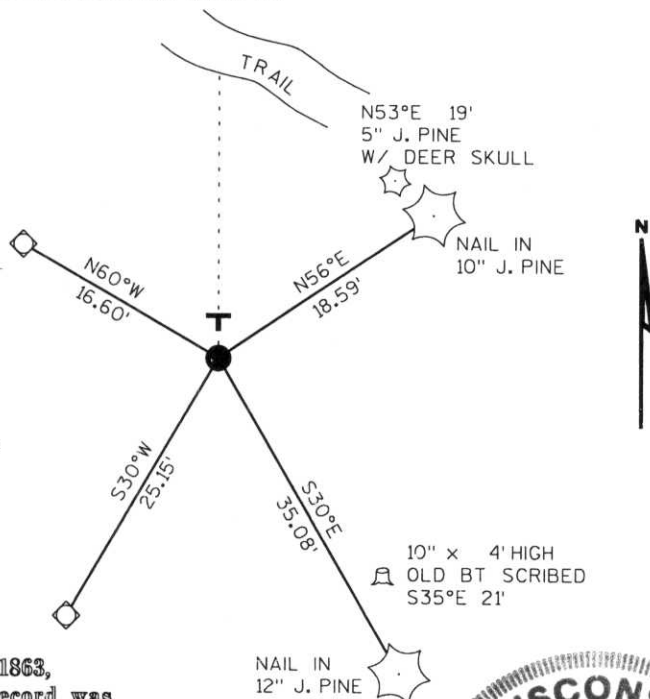

(i) I, Dennis Roberts, Registered Land Surveyor #S-1863, hereby certify that the corner location on this record was determined by me or under my direction and control and that this U.S. Public Land Survey Monument Record is correct and complete to the best of my knowledge and belief.

Dennis B. Roberts
 Signature

5/29/03
 Date



Index No. *****
 E-21



SURVEY MARKER

C-11 KING

Pink tape marking a tree trunk