U.S. PUBLIC LAND SURVEY MONUMENT RECORD


NOTE: This form is intended and designed to fulfill all requirements of Wisconsin Administrative Code, Chapter A-E 7.08 U.S. Public Land Survey Monument Record (3)(a)(b)(c)(d)(e)(f)(g)(h)(i). An additional sheet may be added if necessary to conform with said requirements.

(a) Corner location: Township 35 North

Range 07 East

Town of KING

LINCOLN County, Wisconsin

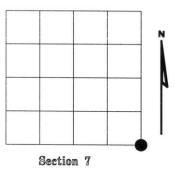

(b)(f)(g)(h) Description of monument found at this corner and if it was accepted, state all evidence (material, testimonial, occupational, plats, records, other monuments) used as a basis for accepting. If not accepted or if nothing was found, state evidence used as basis for establishing location. If reestablished through lost corner proportionate methods, indicate all monuments, distances and directions used to establish. Indicate type of monument found or set and sign post.

1861 - Original corner set by Alfred Millard


1960 - 1968 - 1969 - Bill Stuth's notes shows corner by others found and accepted as corner BT: 24" Oak N01°E 47.0' 22" Oak S08°E 14.0'

2003 - I found 1" dia.iron pipe with 90° elbow and sq. post accepted as corner.
23" Oak S08°E 14.0'

Replaced with Lincoln County Bernsten Monument stamped to identify corner.

S7 2003 **S8** 1863 S18 S17

Witnessed as shown below.

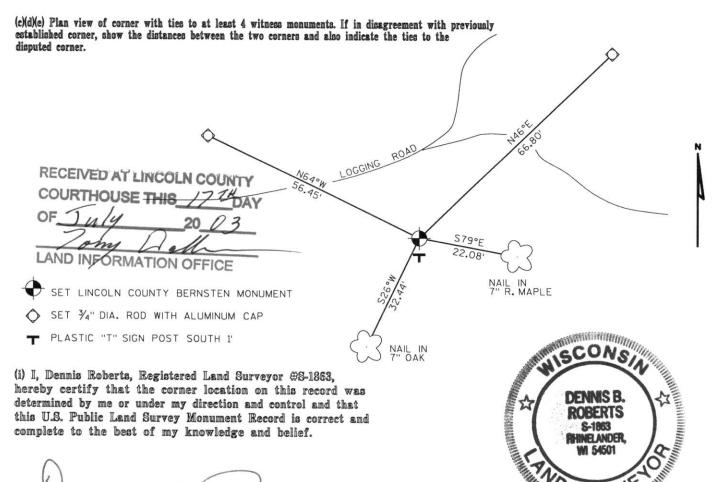

SUR'

Signature

