

CERTIFIED LAND CORNER RESTORATION

Index No. I-21

State of Wisconsin }
County of LINCOLN } ss.

History of original corner establishment:

ED STIEGERWALD SHOWED US A PICTURE FROM THE 1950'S OF A POST WITH PLAC ATTACHED IN THIS SWAMP.

I..... do hereby certify that on the SIXTH day of SEPTEMBER, 1977, I found evidence of the NORTHWEST corner of SECTION 13 Township 35, North, Range 7 EAST, Fourth, Principal Meridian, as described hereon; and that from this evidence I established a new monument and accessories as described hereon to perpetuate the original location of this corner.



Description of corner evidence found:

FOUND OLD BEARING TREE AND MEASURED SOUTH AND FOUND POST WITH PLAC ATTACHED. REPLACED WITH 5' STEEL FENCE POST DROVE 3' TO 4' INTO BOG OF TAGALDER SWAMP AND PLACED TWO, TWO INCH BY 30 INCH IRON PIPE OVER TOP.

Resident witnesses:

.....
.....
.....

Description of monument and accessories I established to perpetuate the original location of this corner.

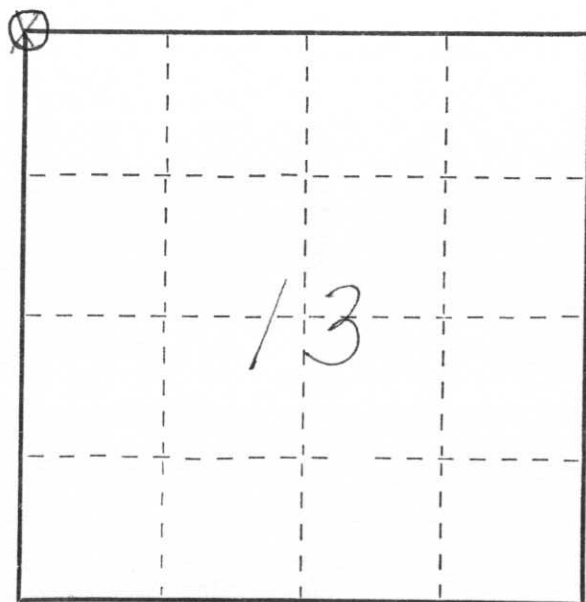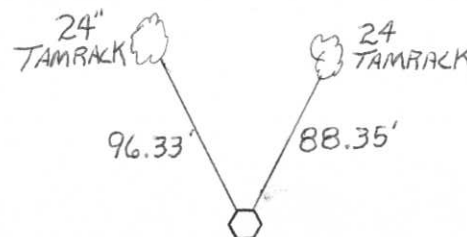

○ = Corner monument restored.

Dated at WAUSAU, Wis., this 21ST day of Oct, 1977.

Signature Dexter J. Nowaczyk Title REGISTERED LAND SURVEYOR Registration No. 51143
(County Surveyor, Registered Land Surveyor, or other duly authorized official)

Office of Register of Deeds, County of....., I hereby certify that the within instrument was filed in this office for record on the..... day of....., 19..... at..... o'clock..... M.

.....
(Register of Deeds)

By..... Deputy





27 3:14PM



27 3:19 PM

