


CERTIFIED LAND CORNER RESTORATION

Index No. M-17

State of Wisconsin }  
County of Lincoln } ss.

I Lester J. Schmit, do hereby  
certify that on the 24th day  
of June, 19 78, I found  
evidence of the Northeast  
corner of Section 22  
Township 35, North, Range  
7 East, Fourth, Principal Meridian,  
as described hereon; and that from this evidence  
I established a new monument and accessories  
as described hereon to perpetuate the original  
location of this corner.

Resident witnesses:

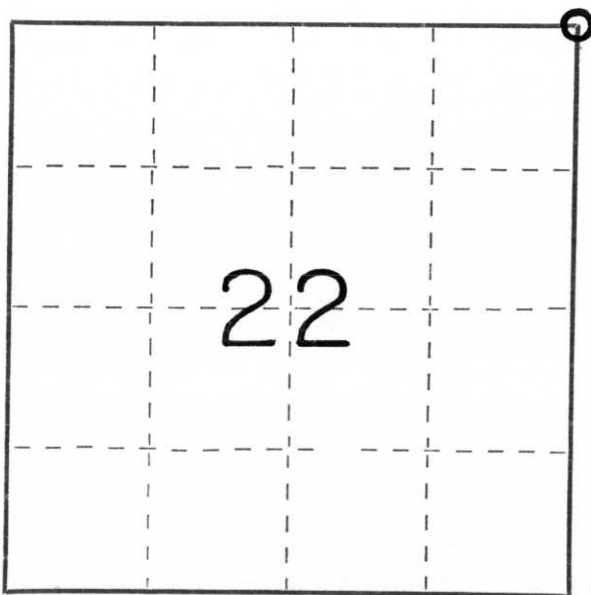

○ = Corner monument restored.

History of original corner establishment:

Surveyor: Alfred Millard  
Date: July 1861  
Monumentation: Wood Post  
Witnesses: 12" White Pine, N 40° W, 35 lks  
Timber blown down no other trees near

Description of corner evidence found: Found 1" iron pipe referenced to on Northwoods  
Surveyors map # 12-15 & 9-16-357. The corner is near the P. I. of the  
curve in County Trunk Highway "A".

Description of monument and accessories I established to perpetuate the original location of this corner.  
Berntsen Monument - 30" (Set at ground level.)

- P.K. Nail in 5" Ash, N 5° E, 78.95'
- P.K. Nail in power pole N 60° E, 35.14'
- P.K. Nail in power pole, S 40° E, 44.17'
- P.K. Nail in power pole, S 35° W, 37.34'

Dated at Tomahawk, Wis., this 31st day of August, 19 78.

Signature Lester J. Schmit Title Land Surveyor Registration No. S-1192  
(County Surveyor, Registered Land Surveyor, or other duly authorized official)

Office of Register of Deeds, County of \_\_\_\_\_, I hereby certify that the within  
instrument was filed in this office for record on the \_\_\_\_\_ day of \_\_\_\_\_, 19 \_\_\_\_\_  
at \_\_\_\_\_ o'clock \_\_\_\_\_ M.

(Register of Deeds)

By \_\_\_\_\_ Deputy



26 10:07 AM





26 10:08 AM



26 10004







26 10:07 AM