

CERTIFIED LAND CORNER RESTORATION


Index No. M-13

State of Wisconsin }
County of Lincoln } ss.

I Lester J. Schmit, do hereby
certify that on the 20 day
of June, 19 78, I found
evidence of the Northwest
corner of Section 22
Township 35, North, Range
7 East, Fourth, Principal Meridian,
as described hereon; and that from this evidence
I established a new monument and accessories
as described hereon to perpetuate the original
location of this corner.

Resident witnesses:

.....
.....
.....

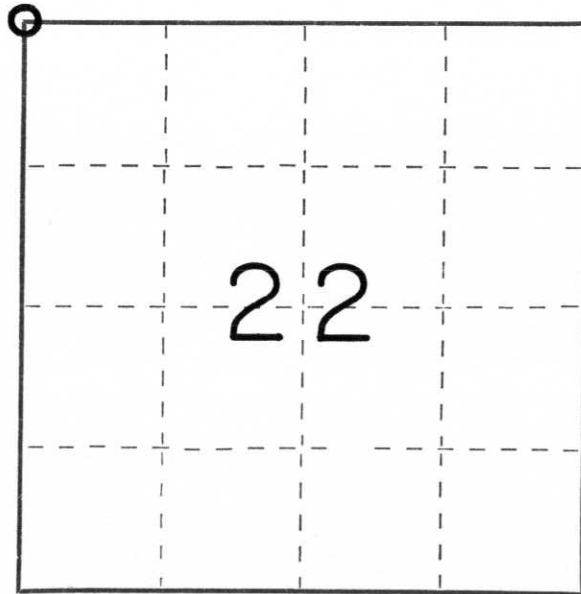

○ = Corner monument restored.

History of original corner establishment:

Surveyor: Alfred Millard

Date: July 1861

Monumentation: Wood Post

Witnesses: 6" Yellow Pine S 85° W, 6 lks
6" White Pine N 46° E, 42 lks

Description of corner evidence found: Found 1" iron pipe referenced to on Northwoods Surveyors map # 12-15 & 9-16-357. The corner is on the centre-line of a River Road, north & south, and along a fence line which runs east & west.

Description of monument and accessories I established to perpetuate the original location of this corner.
Berntsen Monument - 30" (Set 2" below the surface of River Road.)

P.K. Nail in 7" Jack Pine, N 55° E, 48.24'

P.K. Nail in power pole, N 84° E, 19.89'

2" iron pipe, S 52° W, 27.38'

P.K. Nail in 4" Norway Pine, N 50° W, 42.64'

Dated at Tomahawk, Wis., this 31st day of August, 19 78.

Signature Lester J. Schmit Title Land Surveyor Registration No. S-1192
(County Surveyor, Registered Land Surveyor, or other duly authorized official)

Office of Register of Deeds, County of _____, I hereby certify that the within
instrument was filed in this office for record on the _____ day of _____, 19____
at _____ o'clock _____ M.

.....
(Register of Deeds)

By _____ Deputy