

MINK CAPITAL SURVEYING, INC.

SURVEY MONUMENT LOCATION RECORD

SECTION 17
 TOWNSHIP 35 N
 RANGE 7E
LINCOLN
 [CITY, VILLAGE, COUNTY]

LANDMARK BENCHMARK


FOUND
 SET
 RE-SET
 RE-TIED

CORNER IDENTITY NAIL + BOTTLE CAP
 DATE OF SURVEY DEC. 6 1976
 WEATHER CLEAR + COLD
 TEMPERATURE 5° ±
 SURVEY PARTY D. FLUSTY M. HENRICHS
F. STOLTENBERG



BASIS FOR MONUMENT LOCATION
 DESCRIBE METHOD OF SURVEY AND CORNER AUTHENTICATION

TIE SKETCH SHOW HORIZONTAL TIE DISTANCES TO FIXED WITNESS MONUMENTS. DESCRIBE ALL MONUMENTS FOUND OR SET.

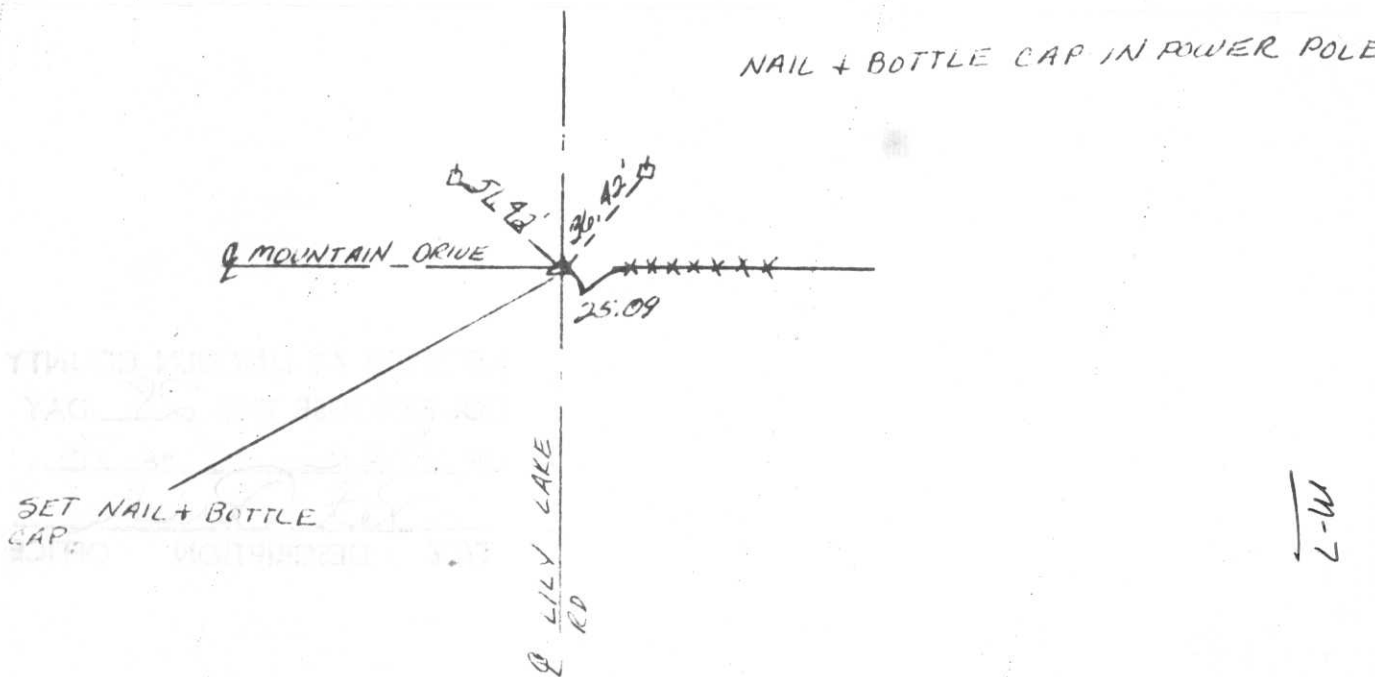



1 1:17 PM





1 1:17 PM



1 1:19PM