




**MINK CAPITAL SURVEYING, INC.**  
**SURVEY MONUMENT LOCATION RECORD**

SECTION 17  
 TOWNSHIP 35 N  
 RANGE 7E  
LINCOLN  
 [CITY, VILLAGE, COUNTY]

LANDMARK     BENCHMARK

FOUND   
 SET   
 RE-SET   
 RE-TIED

CORNER IDENTITY NAIL + BOTTLE CAP  
 DATE OF SURVEY DEC. 6 1976  
 WEATHER CLEAR + COLD  
 TEMPERATURE 5° ±  
 SURVEY PARTY D. FLUSTY M. HENRICHS  
F. STOLTENBERG

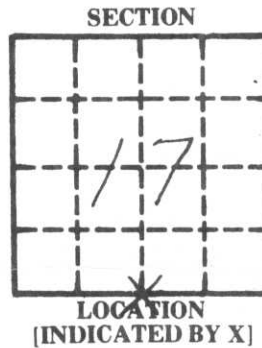


**BASIS FOR MONUMENT LOCATION**

DESCRIBE METHOD OF SURVEY AND CORNER AUTHENTICATION

**TIE SKETCH**

SHOW HORIZONTAL TIE DISTANCES TO FIXED WITNESS MONUMENTS. DESCRIBE ALL MONUMENTS FOUND OR SET.

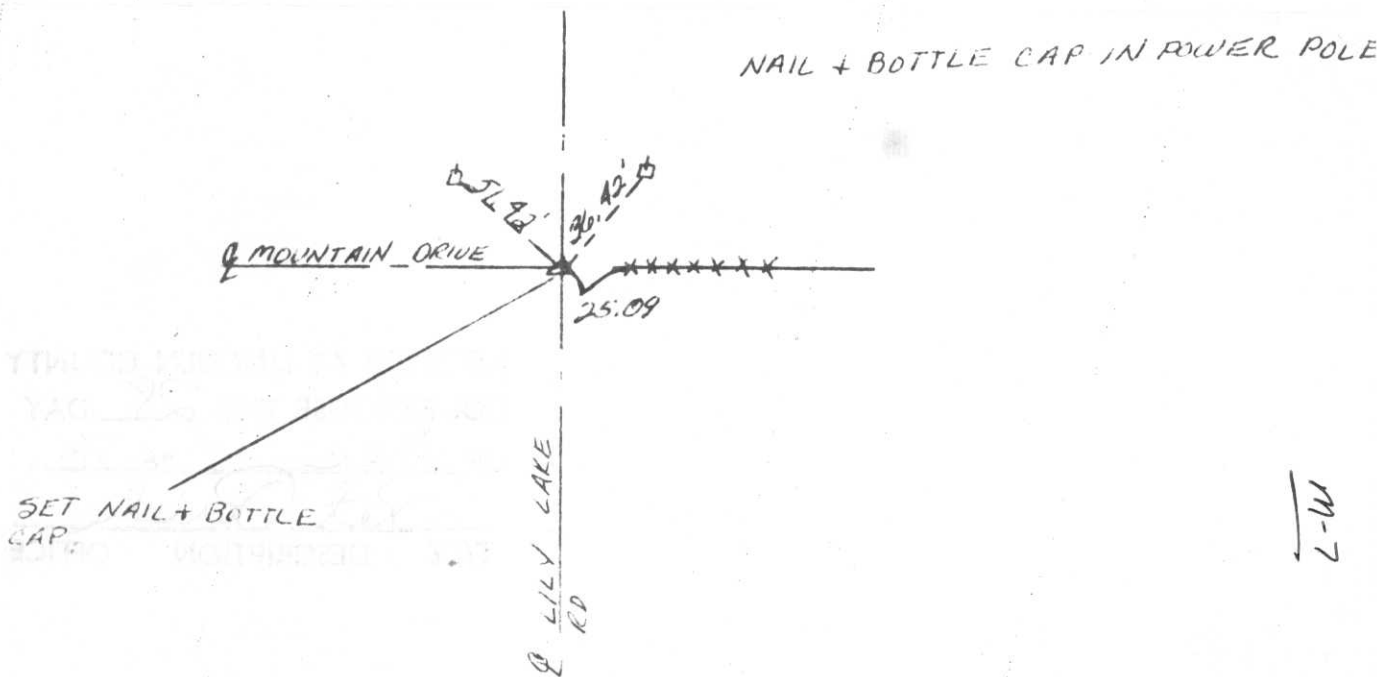



1 1:17 PM





1 1:19 PM



1 1:17 PM





1 1:19PM