

CERTIFIED LAND CORNER RESTORATION


Index No. 0-9

State of Wisconsin }
County of Lincoln } ss.

I Lester J. Schmit do hereby certify that on the 27th day of April, 1984, I found evidence of the West 1/4 corner of Section 21 Township 35, North, Range 7 East, Fourth, Principal Meridian, as described hereon; and that from this evidence I established a new monument and accessories as described hereon to perpetuate the original location of this corner.

Resident witnesses:

.....
.....
.....

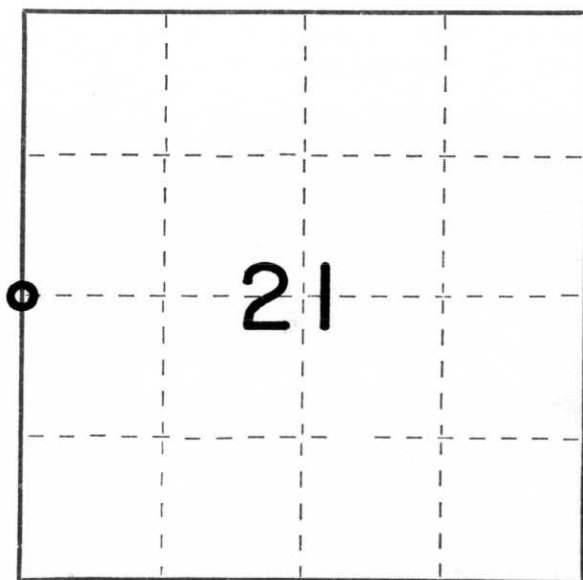

○ = Corner monument restored.

History of original corner establishment:

Surveyor: Alfred Millard

Date: 1 July 1861

Monumentation: Wood Post

Witnesses: 3" Spruce Pine, S 38° E, 78 links
3" Spruce Pine, N 30° E, 3.06 links

Description of corner evidence found: I found a 1 1/4" well point for the corner at the intersection of fence lines from the south and west. Corner is 18' west of the centre of the gravel road (North Pine Road, a Town Road). Witnessed by an 11" Jack Pine, S 71.5° W, 54.32'

Description of monument and accessories I established to perpetuate the original location of this corner.

Set a Berntsen monument near flush to replace the 1 1/4" well point for corner.

Witnessed by: P.K. nail in power pole # 3507-21W4, N 1.5° E, 22.70'
8" red oak, S 58° E, 59.27'
4" red oak, N 57° W, 39.88'

Dated at Tomahawk, Wis., this 10th day of May, 1984.

Signature Lester J. Schmit Title Land Surveyor Registration No. S-1192
(County Surveyor, Registered Land Surveyor, or other duly authorized official)

Office of Register of Deeds, County of _____, I hereby certify that the within instrument was filed in this office for record on the _____ day of _____, 19____ at _____ o'clock _____ M.

.....
(Register of Deeds)

By _____ Deputy



1 3:42 PM



1 3:45 PM

1:34:47 PM

