

CERTIFIED LAND CORNER RESTORATION


Index No. 0-23

State of Wisconsin }
County of Lincoln } ss.

I John H. Fisher do hereby certify that on the _____ day of _____, 19____, I found evidence of the South one quarter corner of Section 25 Township 35, North, Range 7, Fourth, Principal Meridian, as described hereon; and that from this evidence I established a new monument and accessories as described hereon to perpetuate the original location of this corner.

Resident witnesses:

..... none

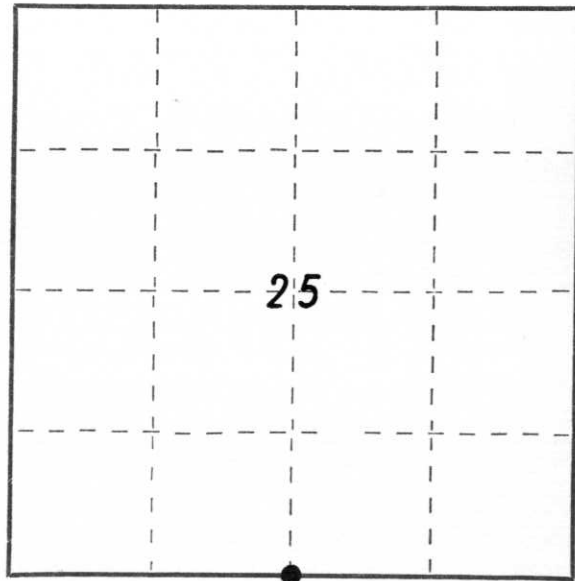

○ = Corner monument restored.

History of original corner establishment:

Date of Original Survey: _____
Survey performed by: _____

June 1861
Alfred Millard - Deputy Surveyor

Witnesses;

12" Maple, N45°W, 28 links
7" Maple, S55°E, 24 links

Description of corner evidence found:

None

Description of monument and accessories I established to perpetuate the original location of this corner.

Set Lincoln County Berntsen Monument by Proportioning

Witnesses:

6" White Birch, S14°E, 16.1 feet
10" Cedar, S78°E, 16.3 feet
8" Cedar, N64°E, 12.9 feet
6" Cedar, N19°W, 33.0 feet



Dated at Minocqua, Wis., this 29th day of June, 1979.

Signature John H. Fisher Title Registered Land Surveyor Registration No. S-836
(County Surveyor, Registered Land Surveyor, or other duly authorized official)

Office of Register of Deeds, County of _____, I hereby certify that the within instrument was filed in this office for record on the _____ day of _____, 19____ at _____ o'clock _____ M.

.....
(Register of Deeds)

By _____ Deputy



26 11:05 AM



26 11:16 AM

26 11:16 AM

