

CERTIFIED LAND CORNER RESTORATION


Index No. U-19

State of Wisconsin }
County of Lincoln } ss.

I Lester J. Schmit, do hereby certify that on the 22nd day of April, 1977, I found evidence of the North 1/4 corner of Section 35 Township 35, North, Range 7 East, Fourth, Principal Meridian, as described hereon; and that from this evidence I established a new monument and accessories as described hereon to perpetuate the original location of this corner.

Resident witnesses:

Frank Petta

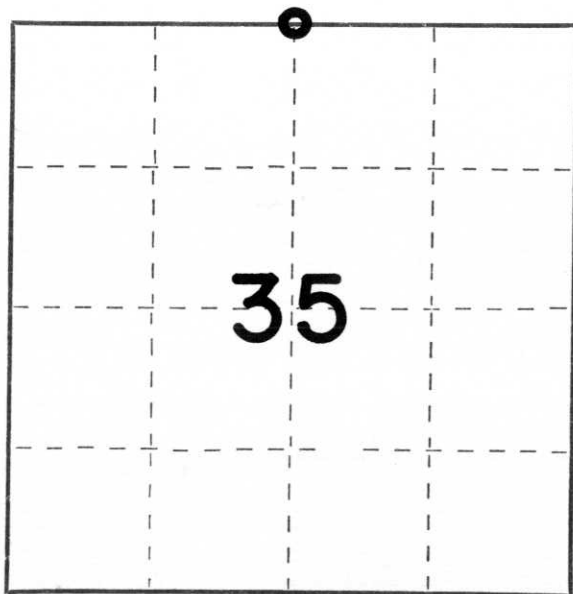

○ = Corner monument restored.

History of original corner establishment:

Surveyor: Alfred Millard
Date: July 1861
Monumentation: Wood Post
Witnesses: Tamarack 14", S 5° W, 10 links
Yellow Birch 8", N 65° E, 14 links

Description of corner evidence found:

Found a very old fence line from the east intersecting with a newer fence line from the south. No wood post or iron pipe at the fence intersection, but Mr. Frank Petta, a long time area resident, witnessed this location as the North 1/4 corner of said Section 35. At that time I placed a 2" iron pipe to mark it's location.

Description of monument and accessories I established to perpetuate the original location of this corner.

Replaced 2" iron pipe with Berntsen monument for the North 1/4 corner.
Witnesses: P.K. nail in 5" Spruce, N 27° E, 24.32'
1" iron pipe, N 89° E, 12.28'
P.K. nail in 9" Balsm, S 03° E, 34.43'
2" iron pipe, N 87° W, 12.64'

Dated at Tomahawk, Wis., this 29th day of October, 1980

Signature Lester J. Schmit Title Land Surveyor Registration No. S 1192
(County Surveyor, Registered Land Surveyor, or other duly authorized official)

Office of Register of Deeds, County of _____, I hereby certify that the within instrument was filed in this office for record on the _____ day of _____, 19____ at _____ o'clock _____ M.

(Register of Deeds)

By _____ Deputy