U.S. PUBLIC LAND SURVEY MONUMENT RECORD

NOTE: This form is intended and designed to fulfill all requirements of Wisconsin Administrative Code, Chapter A-E 7.08 U.S. Public Land Survey Monument Record (3)(a)(b)(c)(d)(e)(f)(g)(h)(i). An additional sheet may be added if necessary to conform with said requirements.


(a) Corner location: Township 35 North

Range 07 East

Town of KING

Signature

LINCOLN County, Wisconsin

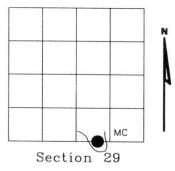


(b)(f)(g)(h) Description of monument found at this corner and if it was accepted, state all evidence (material, testimonial, occupational, plats, records, other monuments) used as a basis for accepting. If not accepted or if nothing was found, state evidence used as basis for establishing location. If reestablished through lost corner proportionate methods, indicate all monuments, distances and directions used to establish. Indicate type of monument found or set and sign post.


1861 - Original corner set by Alfred Millard

2003-Ifound no evidence of corner, established corner on line between section corner in Lake Alice and North $\frac{1}{4}$ corner set previously. Set Lincoln County 1" dia. 30" long alum. pipe with $\frac{1}{2}$ " dia. alum. tablet. monument stamped to identify corner.

Witnessed corner as shown below.

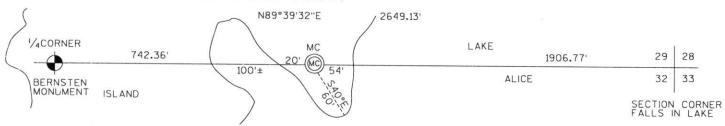

(c)(d)(e) Plan view of corner with ties to at least 4 witness monuments. If in disagreement with previously established corner, show the distances between the two corners and also indicate the ties to the disputed corner.

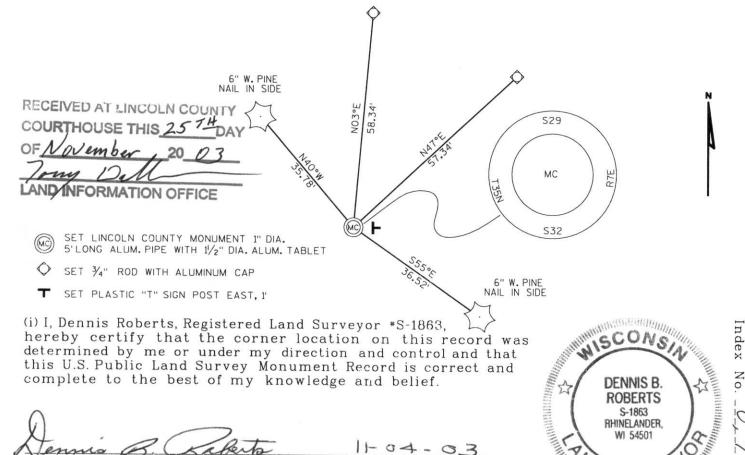

Date

SURVE

