





CERTIFIED LAND CORNER RESTORATION


Index No. A-9

State of Wisconsin }  
County of Lincoln } ss.

I Lester J. Schmit, do hereby certify that on the 26th day of May, 1982, I ~~found evidence of the~~ I set the Northeast corner of Section 5 Township 34, North, Range 7 East, Fourth, Principal Meridian, as described hereon; and that from this evidence I established a new monument and accessories as described hereon to perpetuate the original location of this corner.

Resident witnesses:

.....  
.....  
.....

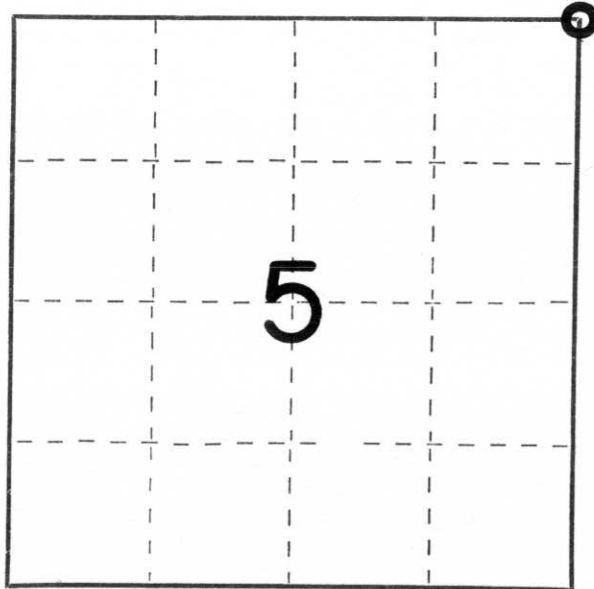


○ = Corner monument restored.

History of original corner establishment:

Surveyor: Jas. M. Marsh  
Date: 16 August 1851  
Monumentation: Wood Post  
Witnesses: Birch 10", S 45° E, 10 links  
Tamarac 9", S 55° W, 36 links  
Tamarac 8", N 66° W, 20 links  
Birch 10", N 18° E, 10 links

Description of corner evidence found: Found no evidence of the corner location so I single proportioned the location between the North 1/4 corner of Section 5 and the Northeast corner of Section 4 as shown below.

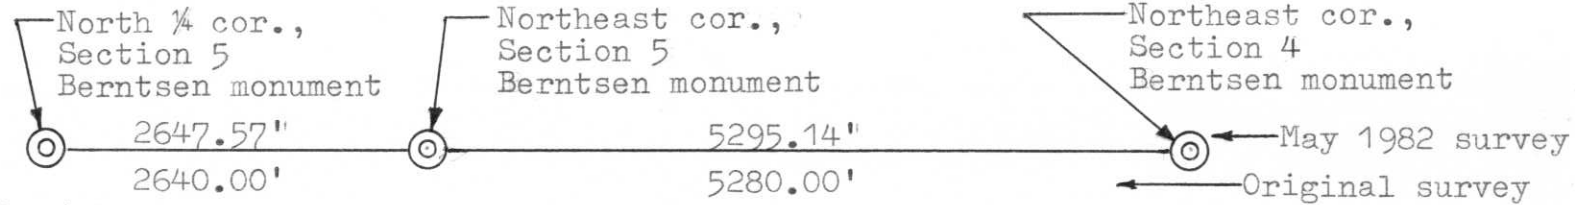

Description of monument and accessories I established to perpetuate the ~~original~~ location of this corner.

Set 30" Berntsen monument for corner 4" below surface and 1' west of the centreline of Tower Road.

Witnesses: P.K. nail in 12" Red Oak, N 15° E, 101.03'  
P.K. nail in 5" White Birch, S 69° E, 27.77"  
P.K. nail in 14" Red Oak, N 72° W, 95.37'  
P.K. nail in power pole (no number), N 20° W, 76.24'

Dated at Tomahawk, Wis., this 7th day of June, 1982.

Signature Lester J. Schmit Title Land Surveyor Registration No. S-1192  
(County Surveyor, Registered Land Surveyor, or other duly authorized official)

Office of Register of Deeds, County of....., I hereby certify that the within instrument was filed in this office for record on the..... day of....., 19..... at..... o'clock..... M.

.....  
(Register of Deeds)

By..... Deputy



31 4:18 PM

R 100



31 4:22 PM



31 4:23 PM