



CERTIFIED LAND CORNER RESTORATION


Index No. A-7

State of Wisconsin }  
County of LINCOLN } ss.

I Stuart L. Foltz, do hereby certify that on the 28th day of January, 1974, I found evidence of the North one-quarter corner of Section 5 Township 34, North, Range 7 East, Fourth, Principal Meridian, as described hereon; and that from this evidence I established a new monument and accessories as described hereon to perpetuate the original location of this corner.

Resident witnesses:

.....  
.....  
.....

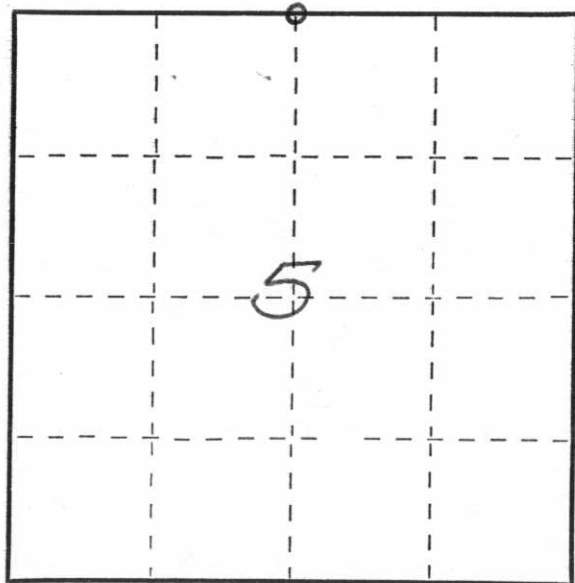

○ = Corner monument restored.

History of original corner establishment:

Original Surveyor: James N. Marsh  
Date of Original Survey: May, 1851  
Original corner monument: Wood post  
Original Bearing trees: Birch 11" S20°E, 22 lks.  
Maple 12" S 8°W, 11 lks.  
Maple 10" N44°W, 23 lks.  
Birch 8" N71°E, 27 lks.

Description of corner evidence found:

Bearing tree: 20" Hemlock scribed "B.T. 1/4" + 20 years old. Research showed that Anton W. Kordick had established the corner on May 17, 1954 and had a 20" Hemlock bearing N83°W, 38'. Corner apparently obliterated by road work on Twin Lakes Road.

Description of monument and accessories I established to perpetuate the original location of this corner.

Set Berntsen monument - 36" - in Twin Lakes Road  
P.K. Nail w/disc in 20" Hemlock N83°W, 38.0'  
P.K. Nail w/disc in 10" Ash N46°E, 46.5'  
P.K. Nail w/disc in 6" Basswood S70°W, 49.8'  
P.K. Nail w/disc in 14" Hemlock N20°E, 57.45'

Set witness iron rod West 25.0'

Dated at Minocqua Wis., this 10th day of December, 1974

Signature Stuart L. Foltz Title Reg. Land Surveyor Registration No. 1170  
(County Surveyor, Registered Land Surveyor, or other duly authorized official)

Office of Register of Deeds, County of \_\_\_\_\_, I hereby certify that the within instrument was filed in this office for record on the \_\_\_\_\_ day of \_\_\_\_\_, 19\_\_\_\_ at \_\_\_\_\_ o'clock \_\_\_\_\_ M.

.....  
(Register of Deeds)

By \_\_\_\_\_ Deputy