

U.S. PUBLIC LAND SURVEY MONUMENT RECORD


Note: This form is intended and designed to fulfill all requirements of Wisconsin Administrative Code, Chapter A-E 5.02, U.S. Public Land Survey Monument Record (3) (a) (b) (c) (d) (e) (f) (g) (h) (i). An additional sheet may be added if necessary to conform with said requirements.

(a) Corner location: Township 35 North

Range 8 East

Town/City/Village Harrison

County Lincoln

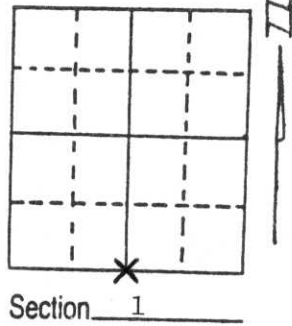

(b) (f) (g) (h) Description of monument found at this corner and if it was accepted, state all evidence (material, testimonial, occupational, plats, records, other monuments) used as a basis for accepting. If not accepted or if nothing was found, state evidence used as basis for establishing location. If reestablished through lost corner proportionate methods, indicate all monuments, distances and directions used to establish.

August 1864 - James Nolwin established this corner and set a wood post with two BTs:
 15" Birch, S5°W, 30 Links (19.80')
 6" Hemlock, N33°E, 18 Links (11.88')


1937 - Francis Fuchs found stake in mound of stone with remains of original Birch BT in place. He made one new BT and set granite monument 6" x 6" x 30".
 12" Sugar Maple, South, 49.2 Links (32.47')

10/2/1992 - Milo E. Stefan found 6" x 6" x 10" pink granite monument with remains of original Birch BT, S5°W, 19.8' and Fuchs BT badly decayed stump, South, 32.5'. We made four new BTs as indicated below.

(c) (d) (e) Plan view of corner with ties to at least 4 witness monuments. If in disagreement with previously established corner, show the distances between the two corners and also indicate the ties to the disputed corner.

- 1) 6" x 6" x 30" Pink Granite Monument.
- 2) 6" Sugar Maple, N39°E, 14.55'.
- 3) 6" Sugar Maple, S43°E, 6.10'.
- 4) 6" Sugar Maple, S50°W, 17.00'.
- 5) 8" Sugar Maple, N21°W, 28.10'.
- 6) Decayed Birch Stump, S5°W, 19.8'.
- 7) Decayed Sugar Maple Stump, South, 32.5'.

Stump blazed and scribed "BT".
 Distances from nail in side of BTs.

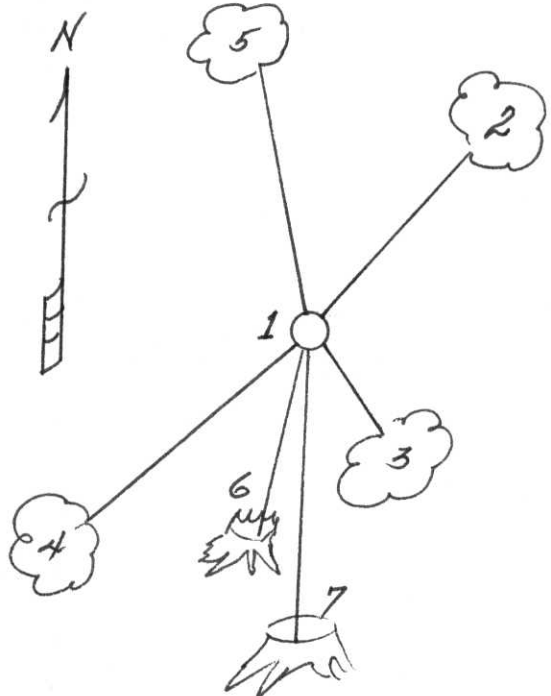

(i) I, Milo E. Stefan
 (type or print name) certify that the corner location on this record was determined by me or under my direction and control and that this U.S. Public Land Survey Monument Record is correct and complete to the best of my knowledge and belief.

Milo E. Stefan
 Signature

3/25/93
 Date

