

CERTIFIED LAND CORNER RESTORATION


Index No. C-17

State of Wisconsin }  
County of Lincoln } ss.

I William E. Bandow, do hereby certify that on the 30 th day of November, 19 84, I found evidence of the East 1/4 corner of Section 3 Township 35, North, Range S. East, Fourth, Principal Meridian, as described hereon; and that from this evidence I established a new monument and accessories as described hereon to perpetuate the original location of this corner.

Resident witnesses:

.....  
.....  
.....

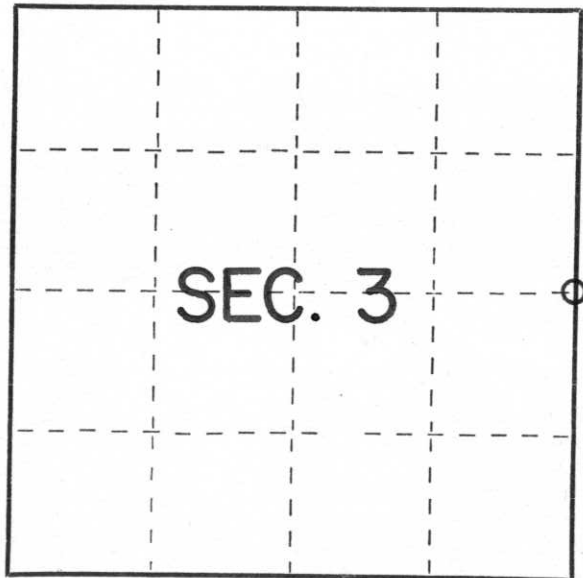

○ = Corner monument restored.

History of original corner establishment:

Corner set by J.L. Nowlin in 1865. South between 2 & 3 45.50 set 1/4 post. BT's Pine 12" N75W 75lks, no others near.

Description of corner evidence found:

No corner found. D.H. Vaughan proportioned corner in 1898 2578' north of Southeast Section corner. I proportioned corner and set it at 2581.15' north of Southeast Section corner.

Description of monument and accessories I established to perpetuate the original location of this corner.

Set a railroad spike in pavement of C.T.H. 'A' at corner location. Corner is 8' south of centerline. Made the following BT's N. Pine 5" N44E 73.16', PK nail in pavement N72E 78.94', 1" iron pipe on Section line North 44.40' and South 64.19'. No others near.

Dated at Rhinelander, Wis., this 5 th day of December, 19 84

Signature: William E. Bandow Title Registered Land Surveyor Registration No. S-1182  
(County Surveyor, Registered Land Surveyor, or other duly authorized official)

Office of Register of Deeds, County of....., I hereby certify that the within instrument was filed in this office for record on the..... day of....., 19..... at..... o'clock..... M.

.....  
(Register of Deeds)

By..... Deputy