

CERTIFIED LAND CORNER RESTORATION

Index No. E-13

State of Wisconsin }  
County of LINCOLN } ss.

History of original corner establishment:

I WILLIAM F. KELLY, do hereby certify that on the 23 rd day of DECEMBER, 19 74, I found evidence of the SECTION corner of SECTIONS 4, 3, 9 & 10 Township 35, North, Range 8 EAST, Fourth, Principal Meridian, as described hereon; and that from this evidence I established a new monument and accessories as described hereon to perpetuate the original location of this corner.

Resident witnesses:

.....  
.....  
.....


Description of corner evidence found:

LOCATED 6" x 6" GRANITE MARKER MARKED:  
ALSO FOUND ONE ORIGINAL BEARING TREE  
WITH OLD SCBIBE MARKS VISIBLE.




*William F. Kelly*

Description of monument and accessories I established to perpetuate the original location of this corner.

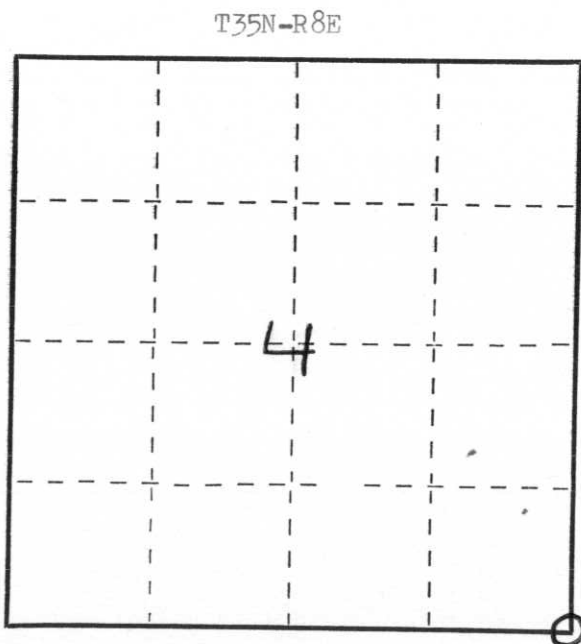

○ = Corner monument restored.

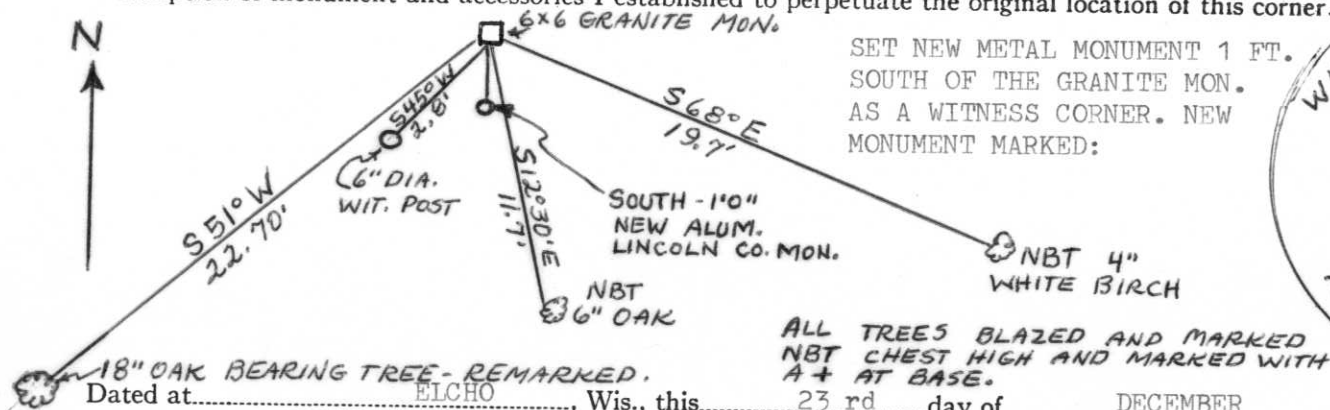

Dated at ELCHO, Wis., this 23 rd day of DECEMBER, 19 74.

Signature William F. Kelly Title REGISTERED LAND SURVEYOR Registration No. S 1098  
(County Surveyor, Registered Land Surveyor, or other duly authorized official)

Office of Register of Deeds, County of \_\_\_\_\_, I hereby certify that the within instrument was filed in this office for record on the \_\_\_\_\_ day of \_\_\_\_\_, 19 \_\_\_\_\_ at \_\_\_\_\_ o'clock \_\_\_\_\_ M.

.....  
(Register of Deeds)

By \_\_\_\_\_ Deputy