

U.S. PUBLIC LAND SURVEY MONUMENT RECORD

NOTE: THIS FORM IS INTENDED AND DESIGNED TO FULFILL ALL REQUIREMENTS OF WISCONSIN ADMINISTRATIVE CODE, CHAPTER A-E 7.08, U.S. PUBLIC LAND SURVEY MONUMENT RECORD (3)(a)(b)(c)(d)(e)(f)(g)(h)(i). ADDITIONAL SHEETS MAY BE NECESSARY TO CONFORM TO SAID REQUIREMENTS.


T 35 N, R 8 E

(a) CORNER LOCATION:

SOUTHEAST CORNER, SECTION 4
 TOWNSHIP 35 NORTH
 RANGE 8 EAST
 TOWN OF HARRISON
 LINCOLN COUNTY
 WISCONSIN

(b) HISTORY OF ORIGINAL CORNER:

ORIGINAL SURVEYOR: See Previous Tie Sheet
 COMMENCING DATE:
 COMPLETION DATE:
 ORIGINAL BEARING TREES:

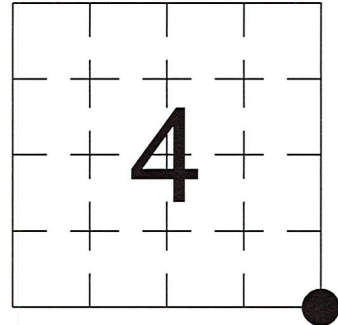



(f)(g)(h) DESCRIPTION OF MONUMENT FOUND AT THIS CORNER AND IF IT WAS ACCEPTED. STATE ALL EVIDENCE (MATERIAL, TESTIMONIAL, OCCUPATIONAL, PLATS, RECORDS, OTHER MONUMENTS) USED AS A BASIS FOR ESTABLISHING LOCATION. IF RE-ESTABLISHING THROUGH LOST CORNER PROPORTIONATE METHODS, INDICATE ALL MONUMENTS, DISTANCES, AND DIRECTIONS USED TO ESTABLISH. INDICATE TYPE OF MONUMENTS FOUND OR SET.

12/23/1974, William F. Kelly found and accepted 6" X 6" Granite Monument.

9/28/2023, I, Anthony R. Dallman, PLS-2405, found a 6" X 6" Granite Monument, up 10". I accepted this location and set witness monuments, as shown in the sketch below, to further perpetuate the corner location.

(c)(d)(e) PLAN VIEW OF THE CORNER WITH TIES TO AT LEAST FOUR WITNESSES. IF IN DISAGREEMENT WITH PREVIOUSLY ESTABLISHED CORNER, SHOW THE DISTANCES BETWEEN THE TWO CORNERS AND ALSO THE TIES TO THE DISPUTED CORNER.


- Tie bearings by hand-held compass.
- Tie distances by steel tape.
- Not to scale.

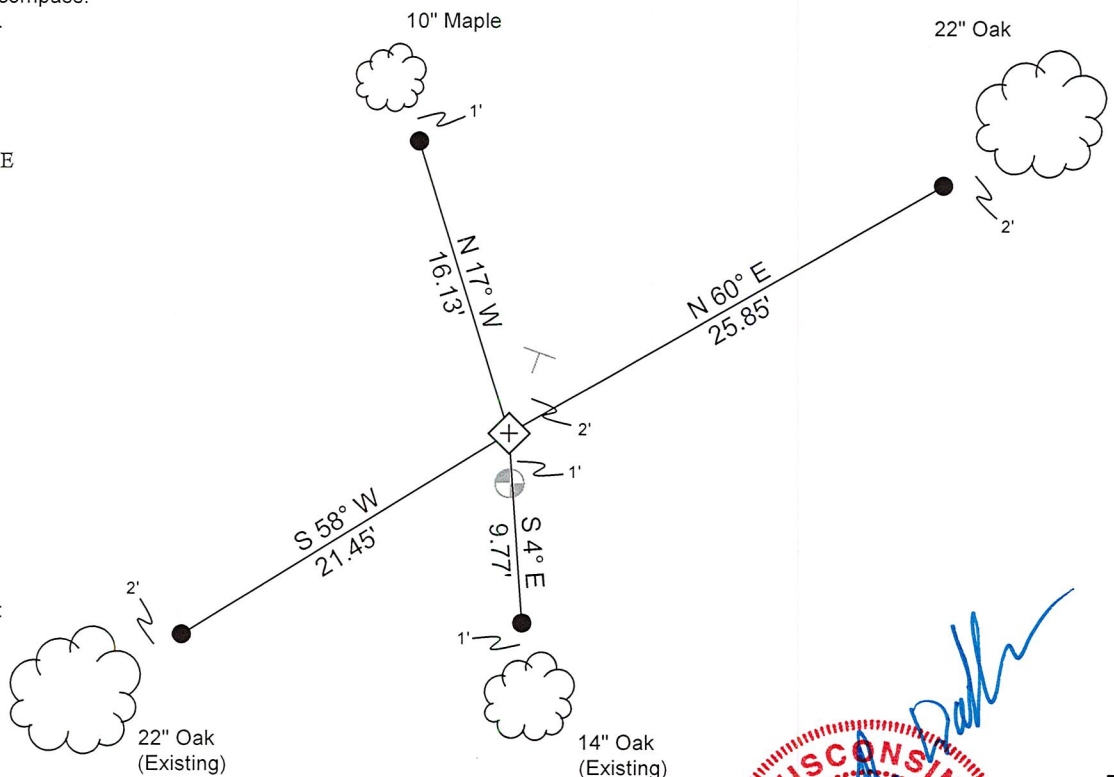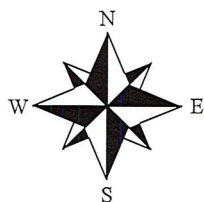

- Berntsen Monument
- Set 3/4" Capped Rebar
- Set Vinyl Post

I, ANTHONY R. DALLMAN, WISCONSIN PROFESSIONAL LAND SURVEYOR, S-2405, HEREBY CERTIFY THAT THE CORNER LOCATION ON THIS RECORD WAS REFERENCED BY ME OR UNDER MY DIRECTION AND CONTROL AND THAT THIS U.S. PUBLIC LAND SURVEY MONUMENT RECORD IS COMPLETE TO THE BEST OF MY KNOWLEDGE AND BELIEF.

Anthony R. Dallman 02/16/24
 ANTHONY R. DALLMAN, PLS S-2405

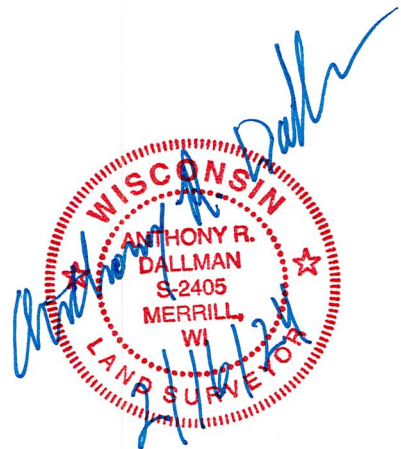

INDEX NO. E-13

43508040000

43508040000_Mon-N



43508040000_North



43508040000_West



4350804000_South



43508040000_East



CERTIFIED LAND CORNER RESTORATION

Index No. E-13

State of Wisconsin }
County of LINCOLN } ss.

History of original corner establishment:

I WILLIAM F. KELLY, do hereby certify that on the 23 rd day of DECEMBER, 19 74, I found evidence of the SECTION corner of SECTIONS 4, 3, 9 & 10 Township 35, North, Range 8 EAST, Fourth, Principal Meridian, as described hereon; and that from this evidence I established a new monument and accessories as described hereon to perpetuate the original location of this corner.

Description of corner evidence found:

LOCATED 6" x 6" GRANITE MARKER MARKED:
ALSO FOUND ONE ORIGINAL BEARING TREE
WITH OLD SCBIBE MARKS VISIBLE.





William F. Kelly

Resident witnesses:

.....
.....
.....

Description of monument and accessories I established to perpetuate the original location of this corner.

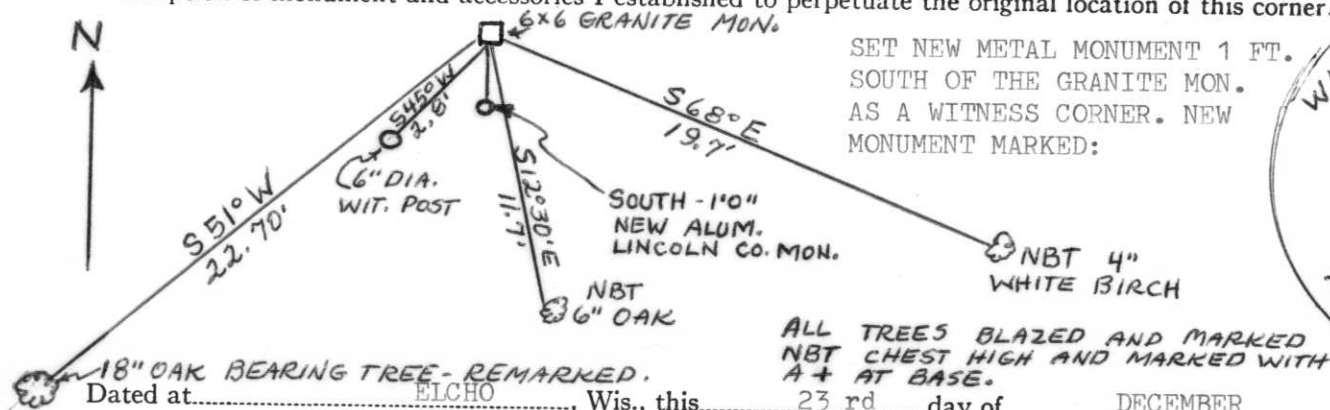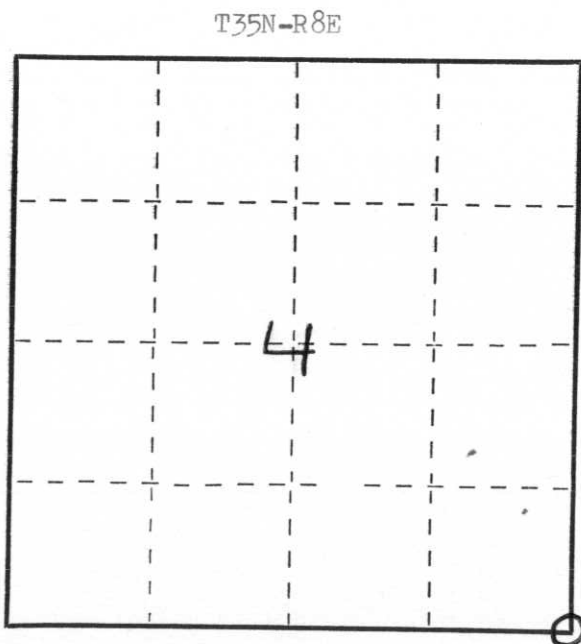

SET NEW METAL MONUMENT 1 FT. SOUTH OF THE GRANITE MON. AS A WITNESS CORNER. NEW MONUMENT MARKED:



ALL TREES BLAZED AND MARKED NBT CHEST HIGH AND MARKED WITH A+ AT BASE.

Dated at ELCHO, Wis., this 23 rd day of DECEMBER, 19 74.

Signature William F. Kelly Title REGISTERED LAND SURVEYOR Registration No. S 1098
(County Surveyor, Registered Land Surveyor, or other duly authorized official)

Office of Register of Deeds, County of _____, I hereby certify that the within instrument was filed in this office for record on the _____ day of _____, 19 _____ at _____ o'clock _____ M.

.....
(Register of Deeds)

By _____ Deputy

○ = Corner monument restored.