

CERTIFIED LAND CORNER RESTORATION

Index No. C-11


State of Wisconsin }
County of LINCOLN } ss.

I WILLIAM F. KELLY, do hereby certify that on the 25th day of NOVEMBER, 1974, I found evidence of the CENTER SECTION corner of SECTION 4 Township 35, North, Range 8 East, Fourth, Principal Meridian, as described hereon; and that from this evidence I established a new monument and accessories as described hereon to perpetuate the original location of this corner.

Resident witnesses:

.....
.....
.....

T35N-R8E

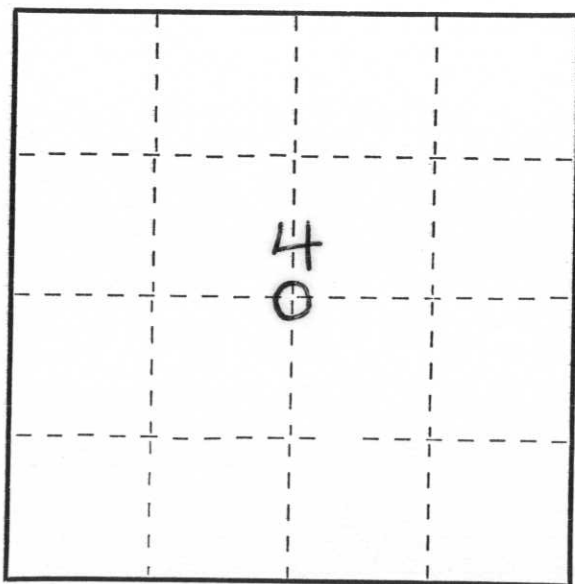

○ = Corner monument restored.

History of original corner establishment:


Description of corner evidence found:

LOCATED 2" PIPE IN PILE OF STONES WITH MARKED WITNESS TREES.



William F. Kelly

Description of monument and accessories I established to perpetuate the original location of this corner.

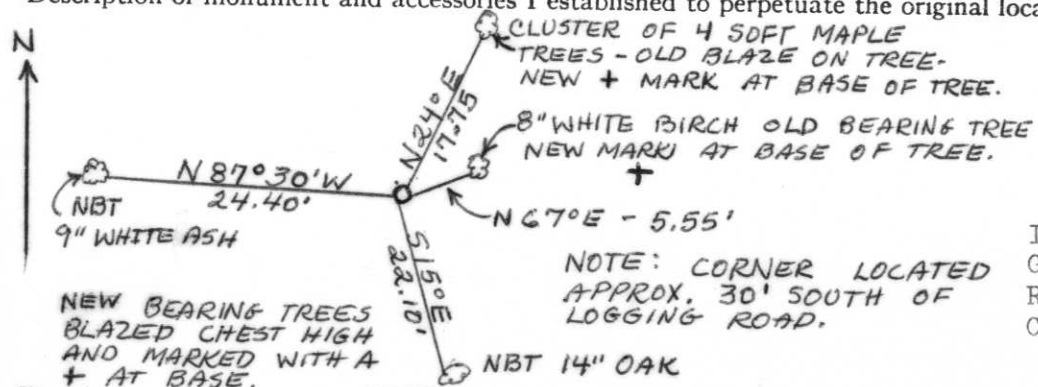

I SET NEW MONUMENT FLUSH WITH GROUND AS CORNER MARKER AND RESET 2" PIPE AS A WITNESS FOR CORNER.

Dated at ELCHO, Wis., this 25th day of NOVEMBER, 1974

Signature William F. Kelly Title REGISTERED LAND SURVEYOR Registration No. S 1098
(County Surveyor, Registered Land Surveyor, or other duly authorized official)

Office of Register of Deeds, County of _____, I hereby certify that the within instrument was filed in this office for record on the _____ day of _____, 19____ at _____ o'clock _____ M.

(Register of Deeds)

By _____ Deputy