

U.S. PUBLIC LAND SURVEY MONUMENT RECORD


Note: This form is intended and designed to fulfill all requirements of Wisconsin Administrative Code, Chapter A-E 5.02, U.S. Public Land Survey Monument Record (3) (a) (b) (c) (d) (e) (f) (g) (h) (i). An additional sheet may be added if necessary to conform with said requirements.

(a) Corner location: Township 35 North

Range 8 East

Town Harrison

County Lincoln

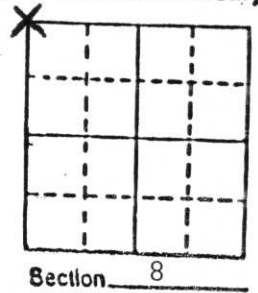

b) (f) (g) (h) Description of monument found at this corner and if it was accepted, state all evidence (material, testimonial, occupational, plats, records, other monuments) used as a basis for accepting. If not accepted or if nothing was found, state evidence used as basis for establishing location. If reestablished through lost corner proportionate methods, indicate all monuments, distances and directions used to establish.

August 1864, James Nowlin at 80.00 chains set post for section corner:

- 12" Yellow Pine, N28°E, 50 links (33.00')
- 15" Yellow Pine, S70°E, 55 links (36.30')
- 14" Yellow Pine)
- 10" Yellow Pine) bearings and distances not given

1937, Francis X. Fuchs found old post and BTs and set granite monument:


- Old 10" Pine stump, N84°W, 43 links (28.38')
- 9" Aspen, N88°W, 142.3 links (93.92')
- 6" Aspen, N33°E, 101.5 links (66.99')

March 3, 1988 Milo E. Stefan found Fuchs granite monument with a steel fence post southeast 2.3'. No trace of aspen was located this day.

c) (d) (e) Plan view of corner with ties to at least 4 witness monuments. If in disagreement with previously established corner, show the distances between the two corners and also indicate the ties to the disputed corner.

1. 6" x 6" x 8" High, red granite monument as set by Francis X. Fuchs in 1937.
2. 6" Aspen, N29°E, 29.10' (T35N R8E S5 BT)*
3. 5" Aspen, S69°E, 28.95 (T35N R8E S8 BT)*
4. 2" Red Pine, S73°W, 31.82 (X BT)
5. 6" Aspen, N15°W, 12.18' (T35N R8E S6 BT)*
6. Steel fence post, southeast 2.3' (BT's scribed accordingly)

*These trees bark scribed only.

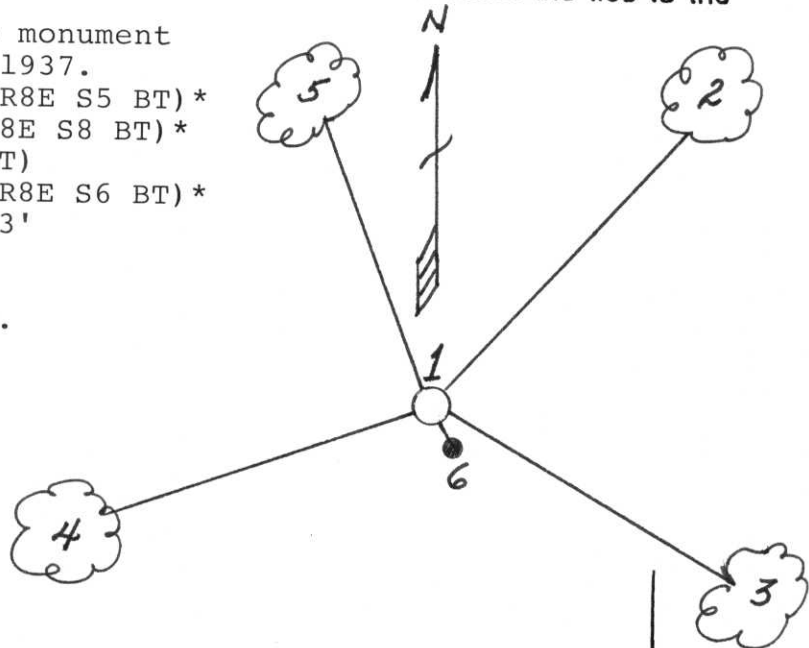

(i) I, Milo E. Stefan

(Type or print name) certify that the corner location on this record was determined by me or under my direction and control and that this U.S. Public Land Survey Monument Record is correct and complete to the best of my knowledge and belief.

Milo E. Stefan

Signature

3/14/88

Date



Index No. E-5



19 10:33 AM



19 10:28 AM



19 10:27 AM

19 10:33 AM

