

# U.S. PUBLIC LAND SURVEY MONUMENT RECORD


**Note:** This form is intended and designed to fulfill all requirements of Wisconsin Administrative Code, Chapter A-E 5.02, U.S. Public Land Survey Monument Record (3) (a) (b) (c) (d) (e) (f) (g) (h) (i). An additional sheet may be added if necessary to conform with said requirements.

(a) Corner location: Township 35 North

Range 8 East

Town Harrison

County Lincoln

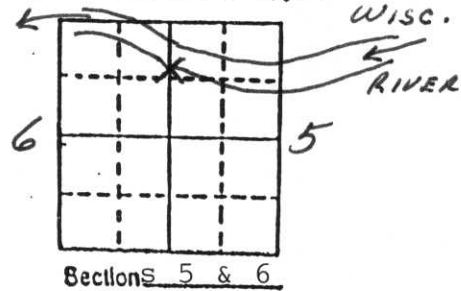

b) (f) (g) (h) Description of monument found at this corner and if it was accepted, state all evidence (material, testimonial, occupational, plats, records, other monuments) used as a basis for accepting. If not accepted or if nothing was found, state evidence used as basis for establishing location. If reestablished through lost corner proportionate methods, indicate all monuments, distances and directions used to establish.

August 1864, James Nowlin set post on south bank of river:

6" Cedar, S39°W, 8 links (5.28')

1937, Francis X. Fuchs found old post and local BT and restored corner by setting a 6" x 6" x 30" Red Granite Stone:

16" Ash (local BT) S76°E, 22 links (14.52')

16" Elm, S68°W, 55.9 links (36.89')


April 6, 1988 Milo E. Stefan found monument heaved out of mound of stone.

Both of Fuchs BTs were badly decayed stumps at given distances and bearings. I reset monument and cut new references.

c) (d) (e) Plan view of corner with ties to at least 4 witness monuments. If in disagreement with previously established corner, show the distances between the two corners and also indicate the ties to the disputed corner.

1. 6" x 6" x 30" Red Granite Monument in mound of stone
2. 6" Black Ash, S75°E, 54.12' (MC BT)
3. 7" Black Ash, S48°E, 53.02' (MC BT)
4. 4" Black Ash, S49°W, 60.22' (MC BT)
5. Gray granite boulder 24" x 30" x 12" with "+" on highest point, S3°E, 30.93'

Distances to nail in side of tree (Trees scribed accordingly)

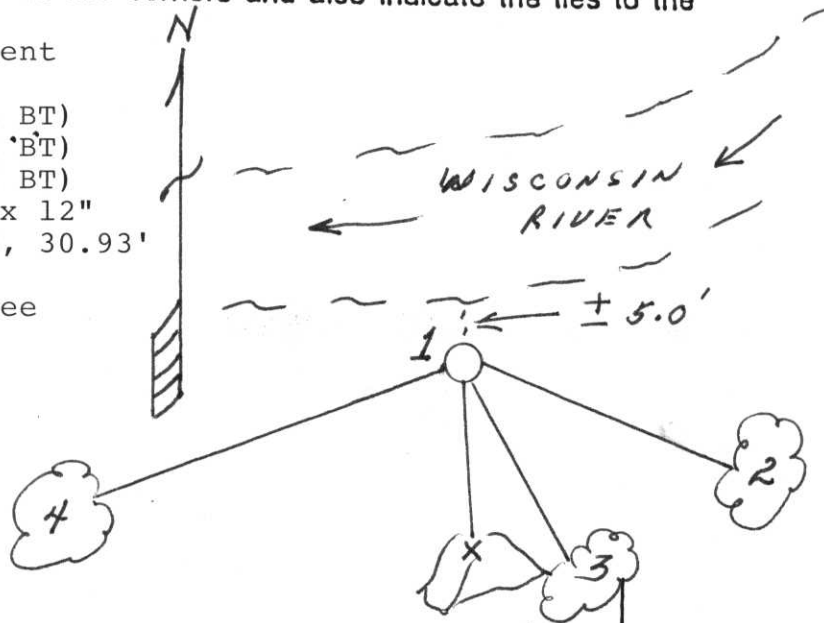

(i) I, Milo E. Stefan

(type or print name) certify that the corner location on this record was determined by me or under my direction and control and that this U.S. Public Land Survey Monument Record is correct and complete to the best of my knowledge and belief.

*Milo E. Stefan*

Signature

4/27/88

Date



Index No. A, B-5  
SOUTH BANK OF RIVER

A-B, 5