


U.S. PUBLIC LAND SURVEY MONUMENT RECORD

Note: This form is intended and designed to fulfill all requirements of Wisconsin Administrative Code, Chapter A-E 5.02, U.S. Public Land Survey Monument Record (3) (a) (b) (c) (d) (e) (f) (g) (h) (i). An additional sheet may be added if necessary to conform with said requirements.

(a) Corner location: Township 35 North
 Range 8 East

Town Harrison
 County Lincoln

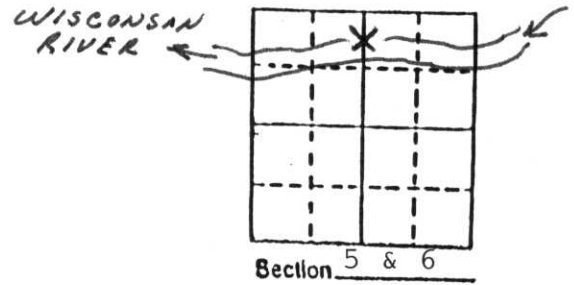

b) (f) (g) (h) Description of monument found at this corner and if it was accepted, state all evidence (material, testimonial, occupational, plats, records, other monuments) used as a basis for accepting. If not accepted or if nothing was found, state evidence used as basis for establishing location. If reestablished through lost corner proportionate methods, indicate all monuments, distances and directions used to establish.

August 1864, James Nowlin at 15.20 chains south intersect right bank of river and set post for M.C. to sections 5 & 6:

- 10" Spruce, N46°W, 30 Links (19.80')
- 12" Spruce, N53°E, 20 Links (13.20")

1937, Francis X. Fuchs restored corner and set granite monument:

- 7" Ash, S79°E, 47.3 Links (31.22')
- 24" Pine Stub, S89°W, 53.8 Links (35.51')


April 26, 1988 Milo E. Stefan found red granite monument, 6" x 6" x 6" in mound of stone, 15' North of river water line.

Fuchs reference nearly gone.
 I made new BTs.

c) (d) (e) Plan view of corner with ties to at least 4 witness monuments. If in disagreement with previously established corner, show the distances between the two corners and also indicate the ties to the disputed corner.

1. 6" x 6" x 6" red granite monument in mound of stone.
2. 7" White Birch, N22°E, 33.58 Feet.
(MC BT)
3. 6" Black Ash, S76°E, 35.15 Feet.
(MC BT)
4. 13" Red Maple, S63°W, 20.44 Feet.
(MC BT)
5. 10" Balsam Fir, N43°W, 29.65 Feet.
(MC BT)

(BTs scribed accordingly)
 Distances to nail in side of trees.

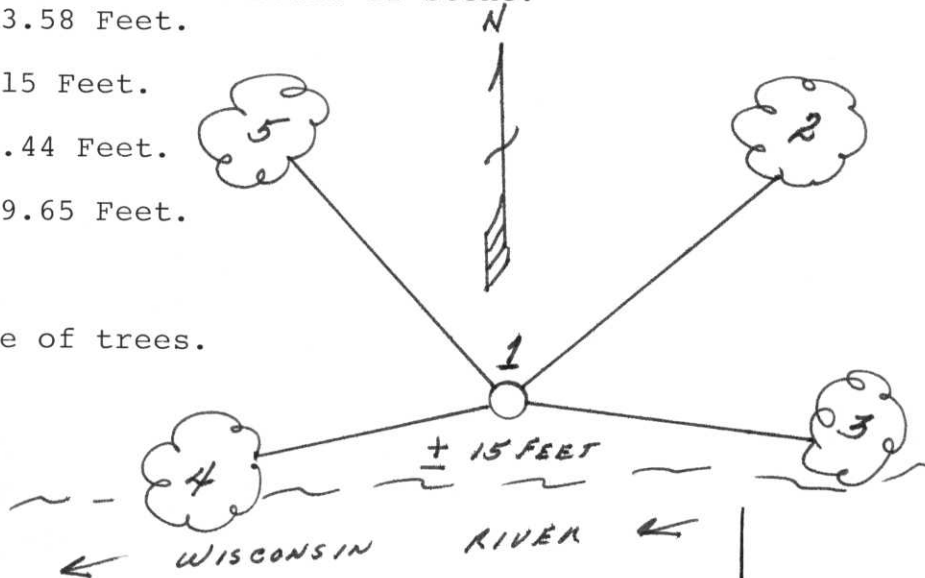

(i) I, Milo E. Stefan
 (Type or print name) certify that the corner location on this record was determined by me or under my direction and control and that this U.S. Public Land Survey Monument Record is correct and complete to the best of my knowledge and belief.

Milo E. Stefan
 Signature

May 27, 1988
 Date



Index No. A, B-5

A-B, 5
 North Bank of River