


U.S. PUBLIC LAND SURVEY MONUMENT RECORD

Note: This form is intended and designed to fulfill all requirements of Wisconsin Administrative Code, Chapter A-E 5.02, U.S. Public Land Survey Monument Record (3) (a) (b) (c) (d) (e) (f) (g) (h) (i). An additional sheet may be added if necessary to conform with said requirements.

(a) Corner location: Township 35 North
 Range 8 East

Town Harrison
 County Lincoln

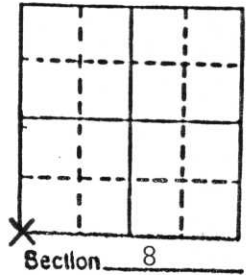

b) (f) (g) (h) Description of monument found at this corner and if it was accepted, state all evidence (material, testimonial, occupational, plats, records, other monuments) used as a basis for accepting. If not accepted or if nothing was found, state evidence used as basis for establishing location. If reestablished through lost corner proportionate methods, indicate all monuments, distances and directions used to establish.

Original survey notes for this corner are not in the Lincoln County surveyor's office. This was done by James Nowlin in August of 1864, this page was missing, however.

1937, Francis X. Fuchs found old stake and BTs. He set a:


1. 6" x 6" x 30" red granite for corner.
2. Old Tamarack BT, N17°W, 14.7 links (9.70')
3. Old Tamarack BT, N86°E, 24.1 links (15.91')
4. 6 1/2" Tamarack, N20°W, 33.9 links (22.37')
5. 6" White Birch, N41°E, 13.8 links (9.11')
6. 6" White Birch, S15°E, 19.8 links (13.07')

March 3, 1988 Milo E. Stefan found Fuchs granite monument with 2" iron pipe and Tamarack picket along side and 3" Tamarack with spike; N32°W, 52.11'.

c) (d) (e) Plan view of corner with ties to at least 4 witness monuments. If in disagreement with previously established corner, show the distances between the two corners and also indicate the ties to the disputed corner.

1. 6" x 6" x 12" high red granite monument as set by Francis X. Fuchs in 1937.
2. 4" White Birch, N52°E, 33.32' (X BT)
3. 8" Tamarack, S43°E, 97.07' (T35N R8E S17BT)
4. 4" Black Spruce, S67°W, 81.44' (X BT)
5. 3" Tamarack, N32°W, 52.11' (X BT)
6. 2" Galv. iron pipe on east side of monument

(BTs scribed accordingly)
 Distances to nail in side of BTs.

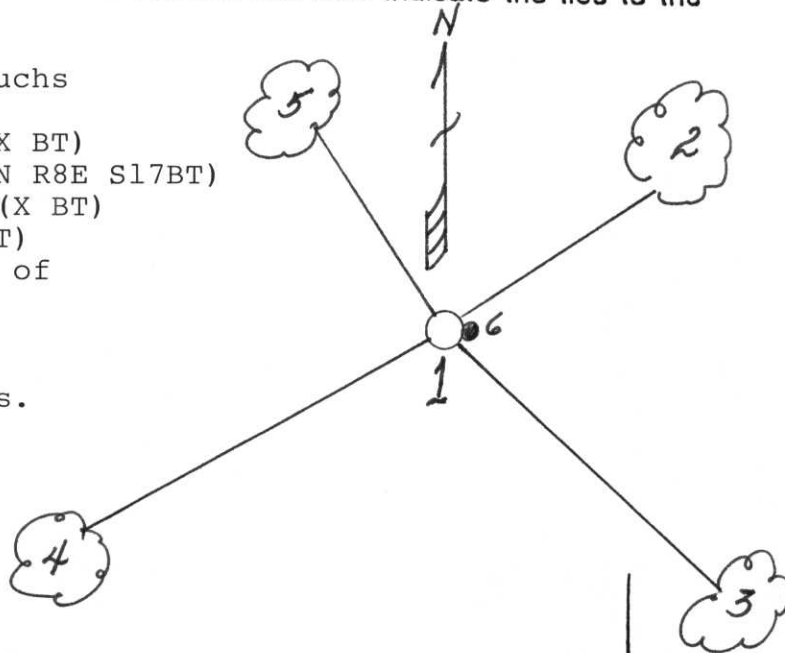

(i) I, Milo E. Stefan

(type or print name) certify that the corner location on this record was determined by me or under my direction and control and that this U.S. Public Land Survey Monument Record is correct and complete to the best of my knowledge and belief.

Milo E. Stefan
 Signature

3/14/88
 Date



Index No. 1-5



13 3:00 PM

PHOTO ©





13 3:01 PM