

U.S. PUBLIC LAND SURVEY MONUMENT RECORD


Note: This form is intended and designed to fulfill all requirements of Wisconsin Administrative Code, Chapter A-E 5.02, U.S. Public Land Survey Monument Record (3) (a) (b) (c) (d) (e) (f) (g) (h) (i). An additional sheet may be added if necessary to conform with said requirements.

(a) Corner location: Township 35 North

Range 8 East

Town Harrison

County Lincoln

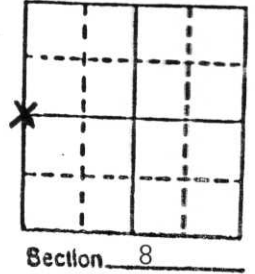

b) (f) (g) (h) Description of monument found at this corner and if it was accepted, state all evidence (material, testimonial, occupational, plats, records, other monuments) used as a basis for accepting. If not accepted or if nothing was found, state evidence used as basis for establishing location. If reestablished through lost corner proportionate methods, indicate all monuments, distances and directions used to establish.

August 1864 by James Nowlin at 40.00 chains set wood post for 1/4 section:
 8" Hemlock, S45°E, 6 links (3.96')

6" White Pine, N55°W, 12 links (7.92')

1937, Francis X. Fuchs restored corner by lost methods and set a 6" x 6" x 30" granite stone for 1/4 corner:

12" N. Pine, S44°E, 56.8 links (37.49')

12" N. Pine, S20°W, 84.4 links (55.70')

April 2, 1979 Lester J. Schmit, RLS #1192 found Fuchs stone and ran east west 1/4 line to section 7.

March 3, 1988 Milo E. Stefan found Fuchs granite monument and 22" Red Pine face grown over, S20°W, 55.7'.

No trace of SE tree found this day.


Fence line westerly, new.

Steel fence post next to monument.

c) (d) (e) Plan view of corner with ties to at least 4 witness monuments. If in disagreement with previously established corner, show the distances between the two corners and also indicate the ties to the disputed corner.

1. 6" x 6" x 8" High red granite monument as set by Francis X. Fuchs in 1937.
2. 16" White Pine, N31°E, 20.00' (1/4S BT)
3. 10" Red Pine, S69°E, 50.18' (1/4S BT)
4. 6" Red Pine, S28°W, 26.26' (1/4S BT)
5. 12" White Pine, West, 22.51' (1/4S BT)
6. 22" Red Pine, S20°W, 55.7'

(BTS scribed accordingly)
 Distances to nail in side of trees.

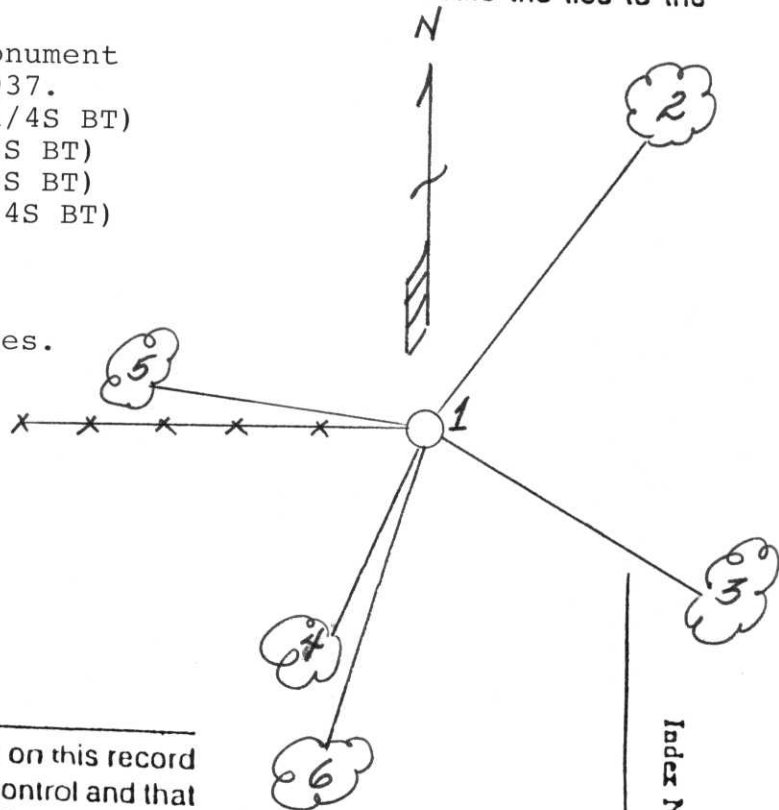

(i) I, Milo E. Stefan
 (type or print name) certify that the corner location on this record was determined by me or under my direction and control and that this U.S. Public Land Survey Monument Record is correct and complete to the best of my knowledge and belief.

Milo E. Stefan
 Signature

3/14/88

Date



Index No. G-5



13 3:22 PM



13 3:23 PM



13 3:22 PM