U.S. PUBLIC LAND SURVEY MONUMENT RECORD


This form is intended and designed to fulfill all requirements of Wisconsin Administrative Code, Note: Chapter A-E 5.02, U.S. Public Land Survey Monment Record (3) (a) (b) (c) (d) (e) (f) (g) (h) (I). An additional sheet may be added if necessary to conform with said requirements.



Range ____8 __ East

Town/City/Village _ HARRISON

County ___ LINCOLN

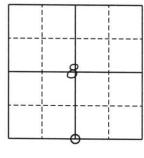

8 Section _

(b) (f) (g) (h) Description of monument found at this corner and if it was accepted, state all evidence (material, testimonial, occupational, plats, records, other monuments) used as a basis for accepting. If not accepted or if nothing was found, state evidence used as a basis for establishing location. If reestablished through lost corner proportionate methods, indicate all monuments, distances and directions used to establish.


THE ORIGINAL CORNER WAS ESTABLISHED BY J. L. NOWLIN IN APRIL, 1865. ORIGINAL NG TREES: 10" HEMLOCK, N15"E, 10 lks.
8" BIRCH, S22"W, 18 lks. BEARING TREES:


FOUND A 6"x 6" GREY GRANITE STONE, SET BY FRANCIS X. FUCHS (FOX) IN 1937, WITH A 5' GREEN AND WHITE WOOD POST TO THE SOUTH AND A BLAZE LINE RUNNING EAST. SET
(4) 7/8" REBARS WITH LINCOLN COUNTY CAPS APPROX. 1 FOOT FROM BEARING TREES.
RECEIVED AT LINCOLN COUNTY

COURTHOUSE THIS 15 TH

DAY

LAND INFORMATION OFFICE (c) (d) (e) Plan view of corner with ties to at least 4 witness monuments. If in disagreement with previously established corner, show the distances between the two corners and also indicate the ties to the disputed corner.

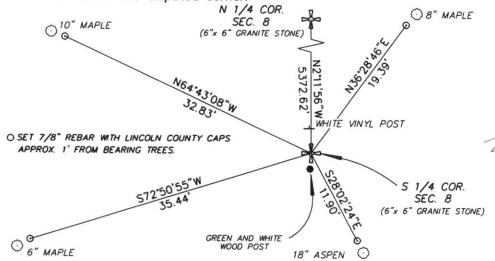

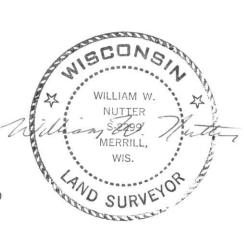

William W. Nutter RLS, S-2299

(type or print name) certify that the corner location on this record was determined by me or under my direction and control and that this U.S. Public Land Survey Monument Record is correct and complete to the best of my knowledge and belief.

Signature

Date

