

CERTIFIED LAND CORNER RESTORATION


Index No. I-23

State of Wisconsin }
County of LINCOLN } ss.

I WILLIAM IMMICH, do hereby certify that on the 4th day of MAY, 19 85, I found evidence of the NORTH 1/4 corner of SECTION 13 Township 35, North, Range 8 EAST, Fourth, Principal Meridian, as described hereon; and that from this evidence I established a new monument and accessories as described hereon to perpetuate the original location of this corner.

Resident witnesses:

.....
.....
.....

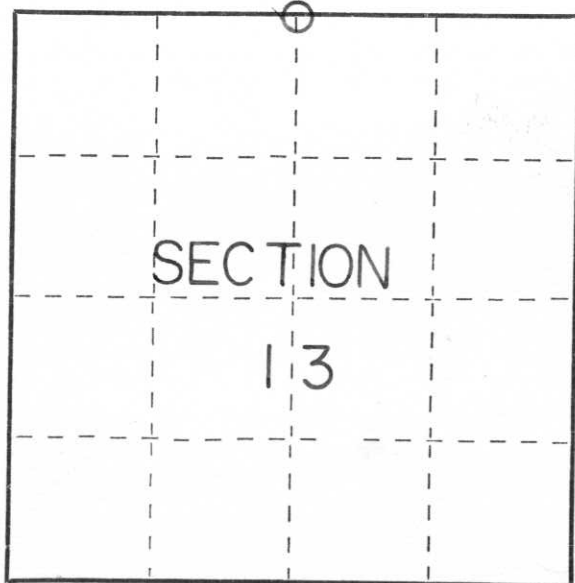

○ = Corner monument restored.

History of original corner establishment:

1865 - NOWLIN GOVT SURVEYOR WEST ON TRUE LINE 39.80 SET 1/4 POST TAM. 6 N 6 W 25, TAM 4 S 4 E 20

F. FOX EAST BET. 12-13 37.38 SET 1/4 STONE EVIDENCED BY OLD STAKE AND BEARING TREES AND TESTIMONY OF RUDOLPH HORN, STONE ON NORTH EDGE OF SMALL OPENING IN THE SWAMP SPRUCE 4 S 71 W 67.4 IK 3 S 20 E 64.8 IK MOUNDED WITH STONE TAM N 39 W 80.3 IK TAM 12 N 35 E 81.6 IK

Description of corner evidence found:

FOUND FOXS STONE MOUNDED WITH STONE



Description of monument and accessories I established to perpetuate the original location of this corner.

6" W. PINE N 46°W 10.10'

4" SPRUCE N 70°E 23.00'

1" X 30" IRON PIPE AT WEST EDGE

BEARINGS MAG. DIST. TO P.K.

5" TAM. S 53°W 53.71

5" SPRUCE S 20°E 42.50'

Dated at RHINELANDER, Wis., this 5th day of MAY, 19 85.

Signature Wille Immich Title R.L.S. Registration No. 1383
(County Surveyor, Registered Land Surveyor, or other duly authorized official)

Office of Register of Deeds, County of _____, I hereby certify that the within instrument was filed in this office for record on the _____ day of _____, 19 _____ at _____ o'clock _____ M.

(Register of Deeds)

By _____ Deputy



11:41 AM



13 11:43 AM

13 11:42 AM

