## U.S. PUBLIC LAND SURVEY MONUMENT RECORD


Note: This form is intended and designed to fulfill all requirements of Wisconsin Public Land Survey Monument Record (3) (a) (b) (c) (d) (e) (f) (g) (h) (i). An conform with said requirements.	Administrative Code, Chapter A-E 5.02, U.S additional sheet may be added if necessary to
(a) Corner location: Township 35 North	
Range8East	
Town/City/VillageHarrison	
CountyLincoln	
	Section_15
(b) (f) (g) (h) Description of monument found at this corner and i (material, testimonial, occupational, plats, records, other monum not accepted or if nothing was found, state evidence used	nents) used as a basis for accepting. If

reestablished through lost corner proportionate methods, indicate all monuments, distances and directions used to establish.

We found this corner marked by a 6"  $\times$  6"  $\times$  30" granite stone monument. This monument was placed by Francis X. Fuchs in 1937. It was placed by Lot Methods (single proportionate measure) at 41.98 chains South and North to respective Section Corners. Both of Fuchs bearing trees are here yet, the Southeast one in good condition, the Southwest one recently broken and in poor condition. We took one new BT and set two witness markers.

> RECEIVED AT LINCOLN COUNTY COURTHOUSE THIS AHD DAY TAX DESCRIPTION **OFFICE**

(c) (d) (e) Plan view of corner with ties to at least 4 witness monuments. If in disagreement with previously established corner, show the distances between the two corners and also indicate the ties to the disputed corner.

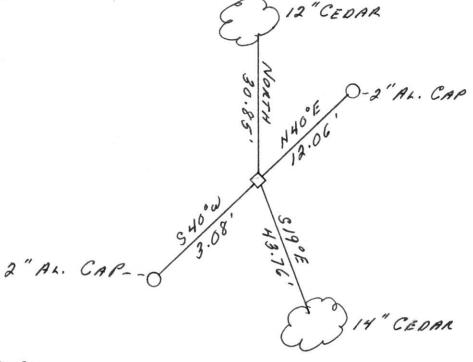

Milo E. Stefan (i) I,\_

(type or print name) certify that the corner location on this record was determined by me or under my direction and control and that this U.S. Public Land Survey Monument Record is correct and complete to the best of my knowledge and belief.

October 26, 1996

Signature

Date



Index No. DAS



