

U.S. PUBLIC LAND SURVEY MONUMENT RECORD


Note: This form is intended and designed to fulfill all requirements of Wisconsin Administrative Code, Chapter A-E 5.02, U.S. Public Land Survey Monument Record (3) (a) (b) (c) (d) (e) (f) (g) (h) (i). An additional sheet may be added if necessary to conform with said requirements.

(a) Corner location: Township 35 North

Range 8 East

Town/City/Village HARRISON

County LINCOLN

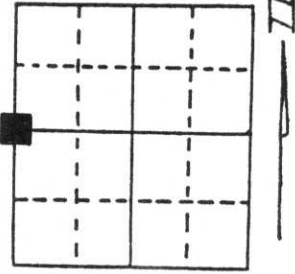


Section 23

(b) (f) (g) (h) Description of monument found at this corner and if it was accepted, state all evidence (material, testimonial, occupational, plats, records, other monuments) used as a basis for accepting. If not accepted or if nothing was found, state evidence used as basis for establishing location. If reestablished through lost corner proportionate methods, indicate all monuments, distances and directions used to establish.

1865-J.L. Nowlin set $\frac{1}{4}$ post and made B.T.'s: Birch 12" S 59° E 25 links, 7" Hemlock West 12 links.
 1937-F. Fox indicates being at corner and found B.T.'s: Maple 12" N 50° W 65.4 links, original Hemlock 9" S 82° W 12.1 links.
 1994-William E. Bandow found 6" X 6" granite monument and witnessed as shown below.

(c) (d) (e) Plan view of corner with ties to at least 4 witness monuments. If in disagreement with previously established corner, show the distances between the two corners and also indicate the ties to the disputed corner.

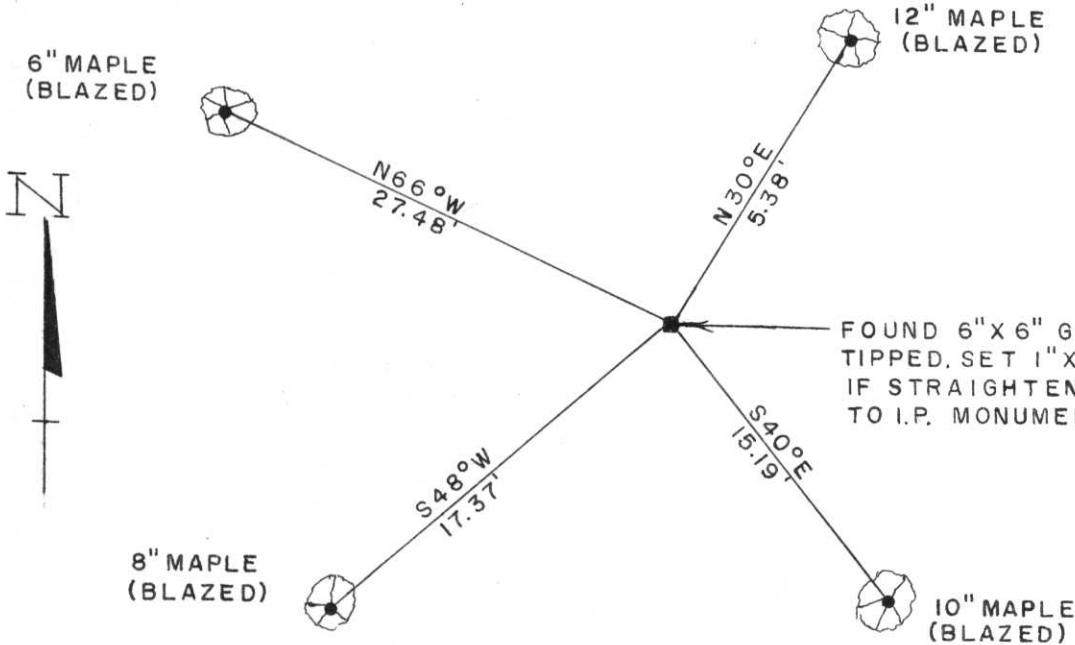

NOTE: NO SCALE. BEARINGS TAKEN WITH A HAND HELD MAGNETIC COMPASS. DISTANCES MEASURED TO 60 PENNY NAILS SET IN SIDE OF TREES.

FOUND 6" X 6" GRANITE MONUMENT TIPPED, SET 1" X 24" I.P. AT LOCATION IF STRAIGHTENED. ALL B.T.'S MEASURED TO I.P. MONUMENT. WAS IDENTIFIED AS SHOWN.

2223

(i) I, WILLIAM E. BANDOW

(type or print name) certify that the corner location on this record was determined by me or under my direction and control and that this U.S. Public Land Survey Monument Record is correct and complete to the best of my knowledge and belief.

William E. Bandow (handwritten signature)

Signature

6-27-94 (handwritten date)

Date



Index No. 0-17

22123

18 1:04 PM



18 12:44 PM



18 12 44 PM