


# U.S. PUBLIC LAND SURVEY MONUMENT RECORD

NOTE: This form is intended and designed to fulfill all requirements of Wisconsin Administrative Code, Chapter A-E 7.08 U.S. Public Land Survey Monument Record (3)(a)(b)(c)(d)(e)(f)(g)(h)(i). An additional sheet may be added if necessary to conform with said requirements.

(a) Corner location: Township 35 North  
 Range 08 East  
 Town of HARRISON  
 LINCOLN County, Wisconsin

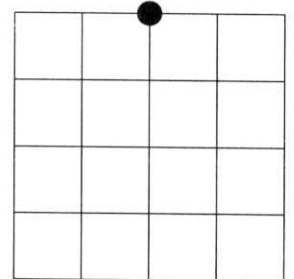

Section 26

(b)(f)(g)(h) Description of monument found at this corner and if it was accepted, state all evidence (material, testimonial, occupational, plats, records, other monuments) used as a basis for accepting. If not accepted or if nothing was found, state evidence used as basis for establishing location. If reestablished through lost corner proportionate methods, indicate all monuments, distances and directions used to establish. Indicate type of monument found or set and sign post.

1865 - Original corner set by Jos. L. Nowlin

1937- Francis Fuchs set 1/4 section corner as evidenced by old stake. Blazes on trees near by. Upon digging uncovered set 6" x 6" granite stone.  
 Spruce 5" N57°E 25.8 Lks.  
 Spruce 3 1/2" S38°E 24.8 Lks.  
 Inscribed in bark.


2003- I found 6" x 6" granite stone and Francis Fuchs BTs.  
 6" Spruce stump N57°E 17.03'  
 4 1/2" Spruce stump S38°E 16.37'

Witnessed as shown below.

(c)(d)(e) Plan view of corner with ties to at least 4 witness monuments. If in disagreement with previously established corner, show the distances between the two corners and also indicate the ties to the disputed corner.

RECEIVED AT LINCOLN COUNTY  
 COURTHOUSE THIS 29<sup>TH</sup> DAY  
 OF September 20 03  
*Zany Dahl*  
 LAND INFORMATION OFFICE

- FOUND 6" x 6" GRANITE MONUMENT
- SET 3/4" ROD WITH ALUMINUM CAP
- PLASTIC "T" SIGN POST SOUTH, 1'

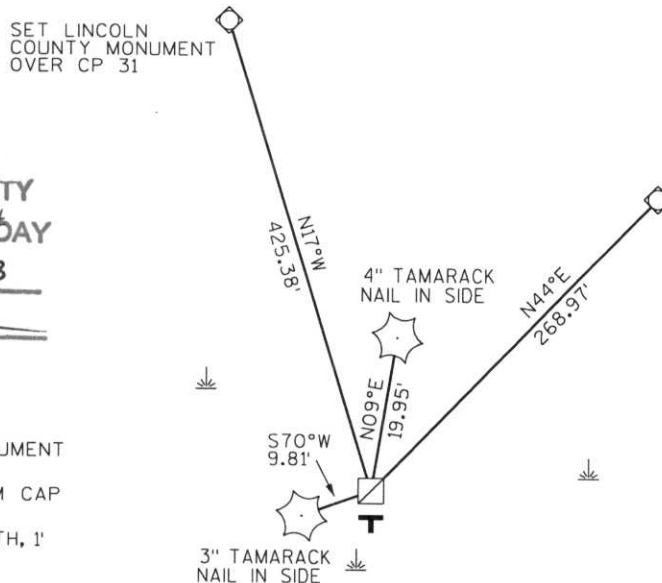

(i) I, Dennis Roberts, Registered Land Surveyor #S-1863, hereby certify that the corner location on this record was determined by me or under my direction and control and that this U.S. Public Land Survey Monument Record is correct and complete to the best of my knowledge and belief.

*Dennis B. Roberts*  
 Signature Date 9/25/03



Index No. Q-19

