## U.S. PUBLIC LAND SURVEY MONUMENT RECORD


Note: This form is intended and designed to fulfill all requirements of Wisconsin Administrative Code, Chapter A-E 7.08 U.S. Public Land Survey Monument Record (3)(a)(b)(c)(d)(e)(f)(g)(h)(i). An additional sheet may be added if necessary to conform with said requirements.

(a) Corner location: Township 35 North

Range 08 (East) West

Town/City/Village HARRISON

County \_\_LINCOLN

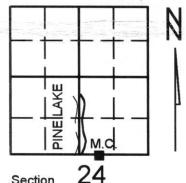

(b) (f) (g) (h) Description of monument found at this corner and if it was accepted, state all evidence (material, testimonial, occupational, plats, records, other monuments)used as a basis for accepting. If not accepted or if nothing was found, state evidence used as basis for establishing location. If reestablished through lost corner proportionate methods, indicate all monuments, distances and directions used to establish. Indicate type of monument found or set and sign post.

-GOVT- SET MEANDER POST AND MADE THE FOLLOWING B.T.s: SPRUCE, 7", S 35° E, 25 LINKS; PINE, 8", N 69°E, 40 LINKS.

- -1937- FRANCIS FOX SET M.C. ON EAST SHORE. NOTES WHITE POST SET BY CONSERVATION COMM. MAKING LAKE IMPROVEMENT WORK S 11°E, 98.6 LINKS.
- -1976- ARVIN HESS NOTES 6" X 6" CONCRETE M.C. ON HIS MAP OF SURVEY.
- -1983- LOFTUS SURVEYING NOTES 6" X 6" MARBLE MONUMENT FOR M.C. ON HIS MAP OF SURVEY
- -1992- DAVID OSTERBRINK NOTES M.C. ON EAST SHORE OF PINE LAKE AND A DISTANCE OF 2063.53' TO THE SE CORNER OF SECTION 24.
- -2000- KEVIN BIXBY FOUND 6" X 6" GRANITE MONUMENT AND WITNESSED AS SHOWN BELOW.

(c) (d) (e) Plan view of corner with ties to at least 4 witness monuments. If in disagreement with previously established corner, show the distances between the two corners and also indicate the ties to the disputed corner.

WY N 89°49'56"E

N 89°49'56"E

S 78°53'41"E

N 89°50'02"E

SE CORNER SECTION 24

1/16 BY
OTHERS
N 89°50'02"E

SECTION 24

LEGEND

FOUND GRANITE MONUMENT

NOTE: NO SCALE. SET ORANGE POST 1.00' WEST OF MONUMENT. SET 1" X 24" IRON PIPE ALONG EAST SIDE OF MONUMENT. MONUMENT IS 20.00' EAST OF PINE LAKE. LAKE LEVEL IS LOW.

- FOUND 1 1/2" CAPPED IRON PIPE
- SET LINCOLN COUNTY CAPPED WITNESS REBAR

(i) I, KEVIN P. BIXBY

(type or print name) certify that the corner location on this record was determined by me or under my direction and control and that this U.S. Public Land Survey Monument Record is correct and complete to the best of my knowledge and belief.

ifly 04/07/00
Date



SHEET 1 OF 1

Ctamn

Index No. Q 23-24





