

# U.S. PUBLIC LAND SURVEY MONUMENT RECORD


Note: This form is intended and designed to fulfill all requirements of Wisconsin Administrative Code, Chapter A-E 5.02, U.S. Public Land Survey Monument Record (3) (a) (b) (c) (d) (e) (f) (g) (h) (i). An additional sheet may be added if necessary to conform with said requirements.

(a) Corner location: Township 35 North

Range 8 East

Town Harrison

County Lincoln

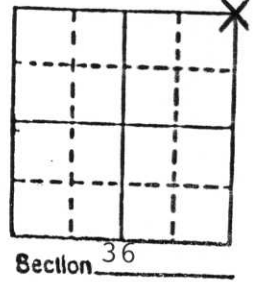

b) (f) (g) (h) Description of monument found at this corner and if it was accepted, state all evidence (material, testimonial, occupational, plats, records, other monuments) used as a basis for accepting. If not accepted or if nothing was found, state evidence used as basis for establishing location. If reestablished through lost corner proportionate methods, indicate all monuments, distances and directions used to establish.

July 4, 1859 Hiram C. Fellows ran north between sections 31 and 36, T35N, R8-9E. At 80.00 chains set post for section corner BTs as follows:

- 11" Birch, N15°E, 11 links (7.26')
- 7" Birch, S65°E, 23 links (15.18')
- 6" Hemlock, S63°W, 12 links (7.92')
- 8" Hemlock, N35°W, 20 links (13.20')

March 13, 1936 V. Maine, Oneida County Surveyor, restored this corner by lost methods and placed a 2" x 60" galv. iron pipe with brass cap.


February 12, 1988 Milo E. Stefan found 2" x 30" galv. iron pipe with brass cap as set by Maine in excellent condition, no ties present.

I accept this as the perpetuated section corner.

c) (d) (e) Plan view of corner with ties to at least 4 witness monuments. If in disagreement with previously established corner, show the distances between the two corners and also indicate the ties to the disputed corner.

1. 2" x 60" galv. iron pipe, 30" above ground with brass cap atop.
2. 5" Hemlock, East, 17.39' ("X BT")
3. 12" Red Maple, S4°E, 25.97' ("T35N R9E S31 BT")
4. 4" Sugar Maple, S51°W, 16.56' ("X BT")
5. 5" Sugar Maple, N11°W, 25.16' ("X BT")

(Trees scribed)  
Measurement to nail in side of trees.

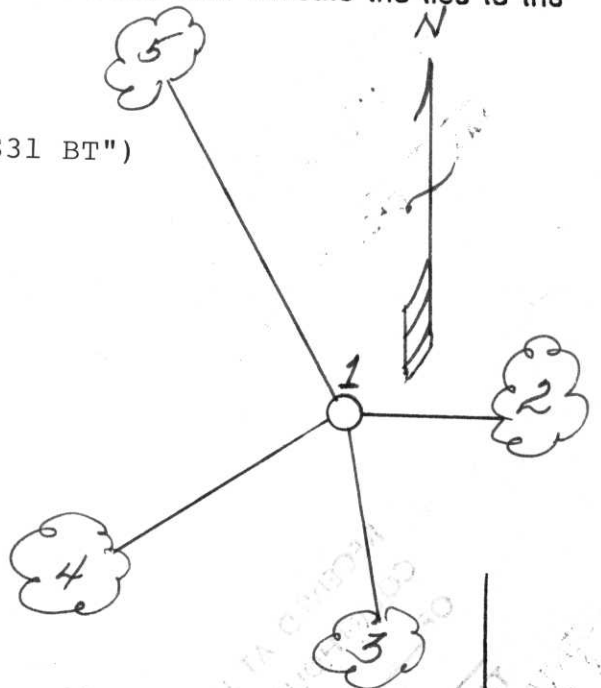

(i) I, Milo E. Stefan  
(type or print name) certify that the corner location on this record was determined by me or under my direction and control and that this U.S. Public Land Survey Monument Record is correct and complete to the best of my knowledge and belief.

Milo E. Stefan 2/26/88  
Signature Date



Index No.

25  
0-25