## U.S. PUBLIC LAND SURVEY MONUMENT RECORD


NOTE: This form is intended and designed to fulfill all requirements of Wisconsin Administrative Code, Chapter A-E 7.08 U.S. Public Land Survey Monument Record (3)(a)(b)(c)(d)(e)(f)(g)(h)(i). An additional sheet may be added if necessary to conform with said requirements.

(a) Corner location: Township 35 North

Range 08 East

Town of HARRISON

LINCOLN County, Wisconsin

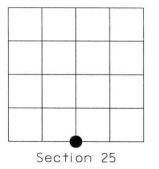

(b)(f)(g)(h) Description of monument found at this corner and if it was accepted, state all evidence (material, testimonial, occupational, plats, records, other monuments) used as a basis for accepting. If not accepted or if nothing was found, state evidence used as basis for establishing location. If reestablished through lost corner proportionate methods, indicate all monuments, distances and directions used to establish. Indicate type of monument found or set and sign post.

1865 - Original corner set by Jos. L. Nowlin

1937- Francis Fuchs- set 6"x6" granite stone mounder with stone. BT: Tamarack stump 21" N70°W 69.7 Lks. BT: Tamarack stump 12" S53°W 81.97 Lks.

2003- Ifound 6"x6" granite stone in rock mound. Fuch's BT Tamarack stump 21" N70°W 46' Fuch's BT Tamarack stump 12" S53°W 54.1' BT by others 12" cedar N58°W 20.1'

Witnessed corner as shown below.

(c)(d)(e) Plan view of corner with ties to at least 4 witness monuments. If in disagreement with previously established corner, show the distances between the two corners and also indicate the ties to the disputed corner.

RECEIVED AT LINCOLN COUNTY

SET NAIL IN

COURTHOUSE THIS OF DAY DAY DE 10" CEDAR

OF 20 03

LAND INFORMATION OFFICE

FOUND 6"x6" GRANITE MONUMENT

SET NAIL IN SIDE

9" CHERRY

(i) I, Dennis Roberts, Registered Land Surveyor #S-1863, hereby certify that the corner location on this record was determined by me or under my direction and control and that this U.S. Public Land Survey Monument Record is correct and complete to the best of my knowledge and belief.

Dermo B. Raferto.
Signature

5/02/03



Index No. 4-23

