

# Attachment to Tie Sheet U-15, T35N, R8E

43508270020

I visited the corner on 10/22/2018 to verify the corner and reference tie monumentation. I found the Granite monument and all 4 ties from Dennis Roberts (MSA) tie sheet (05/02/2003). The established Coordinates and all 4 ties agree with existing monument.

*Anthony R. Dallman* 4/02/19

Anthony R. Dallman, PLS-2405


Lincoln County Surveyor



# U.S. PUBLIC LAND SURVEY MONUMENT RECORD

NOTE: This form is intended and designed to fulfill all requirements of Wisconsin Administrative Code, Chapter A-E 7.08 U.S. Public Land Survey Monument Record (3)(a)(b)(c)(d)(e)(f)(g)(h)(i). An additional sheet may be added if necessary to conform with said requirements.

(a) Corner location: Township 35 North  
 Range 08 East  
 Town of HARRISON  
 LINCOLN County, Wisconsin

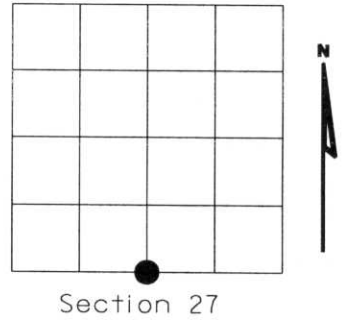

(b)(f)(g)(h) Description of monument found at this corner and if it was accepted, state all evidence (material, testimonial, occupational, plats, records, other monuments) used as a basis for accepting. If not accepted or if nothing was found, state evidence used as basis for establishing location. If reestablished through lost corner proportionate methods, indicate all monuments, distances and directions used to establish. Indicate type of monument found or set and sign post.

1865 - Original corner set by Jos. L. Nowlin

1937- Francis Fuchs- set 6"x6" granite stone, mounded with stone by proportional measurements.  
 BTs: W. Pine 12" S04°E 150.6 Lks.  
 N. Pine 12" N35°E 125.3 Lks.


2003- I found 6"x6" granite stone, mounded with stone  
 Fuchs BTs: 34" W. Pine S04°E 99.4'  
 BT by others: 15" R. Pine N43°E 78.70'

Witnessed corner as shown below.

(c)(d)(e) Plan view of corner with ties to at least 4 witness monuments. If in disagreement with previously established corner, show the distances between the two corners and also indicate the ties to the disputed corner.

RECEIVED AT LINCOLN COUNTY  
 COURTHOUSE THIS 10<sup>TH</sup> DAY  
 OF May 20 03  
*Tony Dallen*  
 LAND INFORMATION OFFICE

- FOUND 6"x6" GRANITE MONUMENT
- SET 3/4 ROD WITH ALUMINUM CAP
- T** PLASTIC "T" SIGN SET 2' NORTH

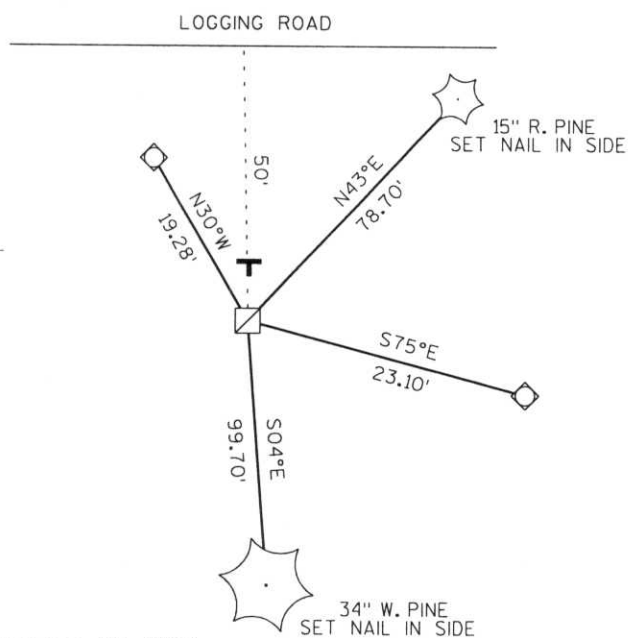

(i) I, Dennis Roberts, Registered Land Surveyor #S-1863, hereby certify that the corner location on this record was determined by me or under my direction and control and that this U.S. Public Land Survey Monument Record is correct and complete to the best of my knowledge and belief.

*Dennis B. Roberts*  
 Signature

5/02/03  
 Date

Index No. V-15